

Cowley

KANSAS

Section 8 Township 33 Range 3E

Well No. #4 Jennings

Company Martin Wunderlich

NORTH

	0						

WEST

EAST

SOUTH

Sec. 8 Twp. 33 R. 3E

Well No. #4 Jennings Farm

Martin Wunderlich Company


Thrulow Contractor

_____ Ft. from N. Line

330 Ft. from S. Line

_____ Ft. from E. Line

990 Ft. from W. Line

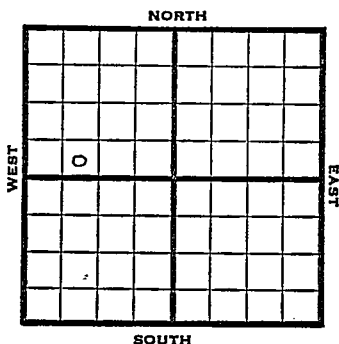

SE SW NW

1951 Elev. 1129' REPORT

11/28 RUR

1952
2/6 TD 3450 5" @ 3484

2/13 DD 3495' Arb. 3493
250 A POP

2/20 Spud 12-7-51
Oil Well TD 3495'
8" @ 92

KC 2707 Miss. 3450
5" @ 3484 TD 3495
Arb. 3493
Comp. 40 bopd

COMPLETED

