
Form 51-5M-12-36 Com'l

Ellis KANSAS

Section 4 Township 12 Range 17-W

Well Number 1 Bemis

Company Wolfe Creek

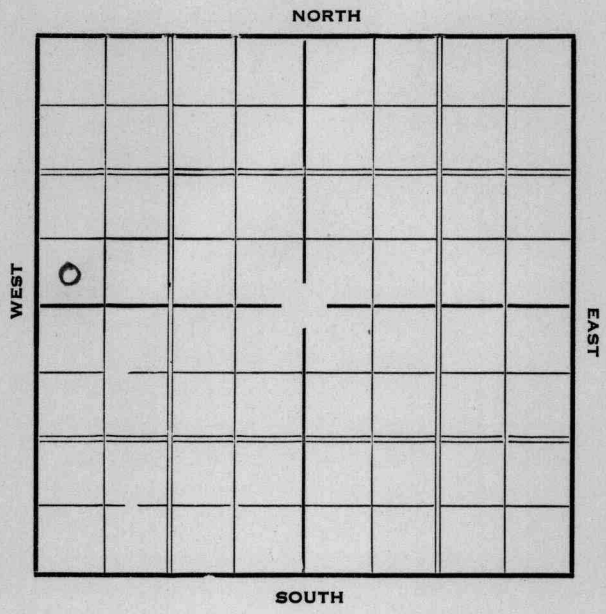


Form 252-A
5M 7-35 MPC

KANSAS Ellis

Map No. _____ Sec. 4 Twp. 12 R. 17-W

Well No. #1 Bemis Farm

Wolfe Creek Company

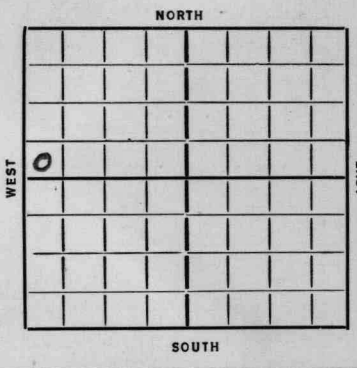

_____ Ft. from N. Line

330 Ft. from S. Line

_____ Ft. from E. Line

330 Ft. from W. Line

Elev. 2096

Date	REPORT
1936	
12/16	R O G
12/24	"
12/29	Cable rig.
1937	
1/7	Rigging up
1/14	" "
1/21	" "
1/28	Shut down.
2/4	" "
2/11	" "
2/19	" "
2/26	" "
3/4	" "
3/11	" "
3/18	" "
3/25	" "
4/2	Surface hole
4/8	Drlg. 1060'
4/16	Drlg. 1970', 10" @ 1046'
4/23	Drlg. 2850'.

OVER

1937

4/30 Top K. C. 3315'.
T.D. 3459' SD.

5/7 Sil. 3564'. 7" @ 3564'.
T.D. 3568'. 3000' oil.
Swabbing.

5/12 6" @ 3564'.
Sil. 3564'.
T.D. 3568'.
Potential 2851 bbls. 24 hrs.
Natural.

COMPLETED

Ellis Form 20—1M Bks.—2-29 KANSAS


Map No. 71 Sec. 4 Twp. 12 R. 17W

Well No. 1 Bemis

Hoffe Oreek. Company

Contractor

SECTION PLAT

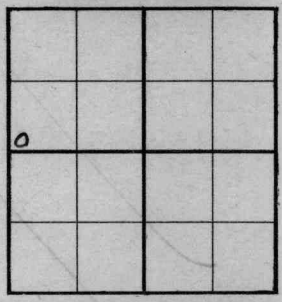

_____ Ft. from N. Line

330 Ft. from S. Line

_____ Ft. from E. Line

330 Ft. from W. Line

FIRST REPORT

Location _____

Rig up _____

Drilling and Remarks:

ROG

RECORD

Cased _____ in., _____ ft.

Sand _____

Gas _____

Oil _____

Total Depth _____

PRODUCTION

1st 24 hrs. Nat. _____

1st 24 hrs. after shot _____

Gas _____ Cu. Ft.

Dry Hole _____

Abandoned _____

Date

DEC 16 1936 19 _____

S. J. LEWIS Scout

Form 26—1M Bks.—2-29 Ellis KANSAS

Map No. 71 Sec. 4 Twp. 12 R. 17 W

Well No. 1 - Bemis

Wolfe Creek Company

Contractor

COMPLETED


_____ Ft. from N. Line

330 Ft. from S. Line

_____ Ft. from E. Line

330 Ft. from W. Line

SECTION PLAT

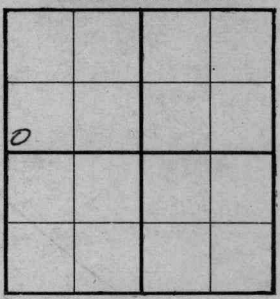

Location _____

Rig up _____

Drilling and Remarks:

Pot - 285 Nat / 24 hrs

RECORD

Cased 6 in., 3564 ft.

~~Sand~~ Sil - 3564

Gas _____

Oil _____

Total Depth 3568

PRODUCTION

1st 24 hrs. Nat. _____

1st 24 hrs. after shot _____

Gas _____ Cu. Ft.

Dry Hole _____

Abandoned _____

Date

MAY 12 1937 19____

H. D. Hatfield Scout