


Section 4 Township 12 Range 17W

Well No. #2 Bemis

Company Westgate-Greenland

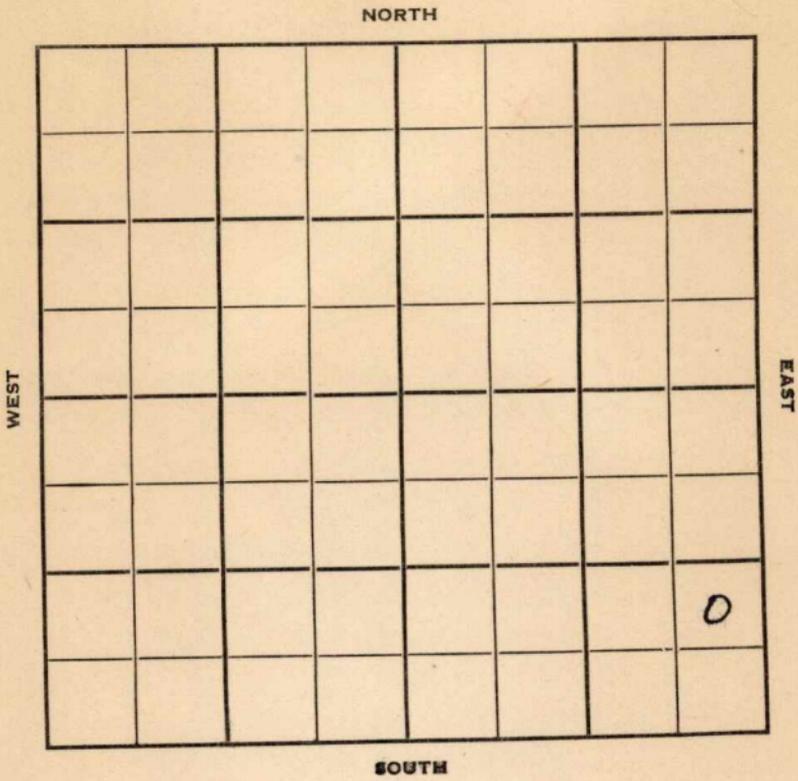

KANSAS

Ellis

Sec. 4 Twp. 12 R. 17-W

Well No. #2 Bemis Farm

Westgate-Greenland Company

Jackson Drlg. Contractor

Bemis


_____ Ft. from N. Line

990 Ft. from S. Line

330 Ft. from E. Line

_____ Ft. from W. Line

NE SE SE

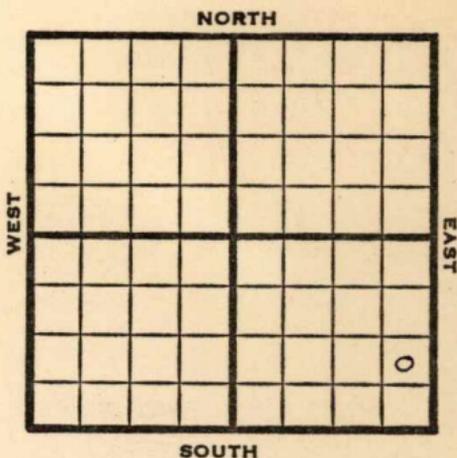

1950 **Elev 2096** REPORT

9/27 MIR

10/25 Spud 9-27-50
8" @ 166

Anjy 1310

Heeb 3278

Lans 3327

Arb 3587-93

5 1/2" @ 3589

TD 3607 SSO 2000 A

S/5 goph

DD 3611 water

D&A TD 3611

ABANDONED

