


Ellis

KANSAS

Section 4 Township 12 Range 17-W

Well Number 1 Benis "A"

Company ~~Wolfe Creek et al~~ T.M. Deal

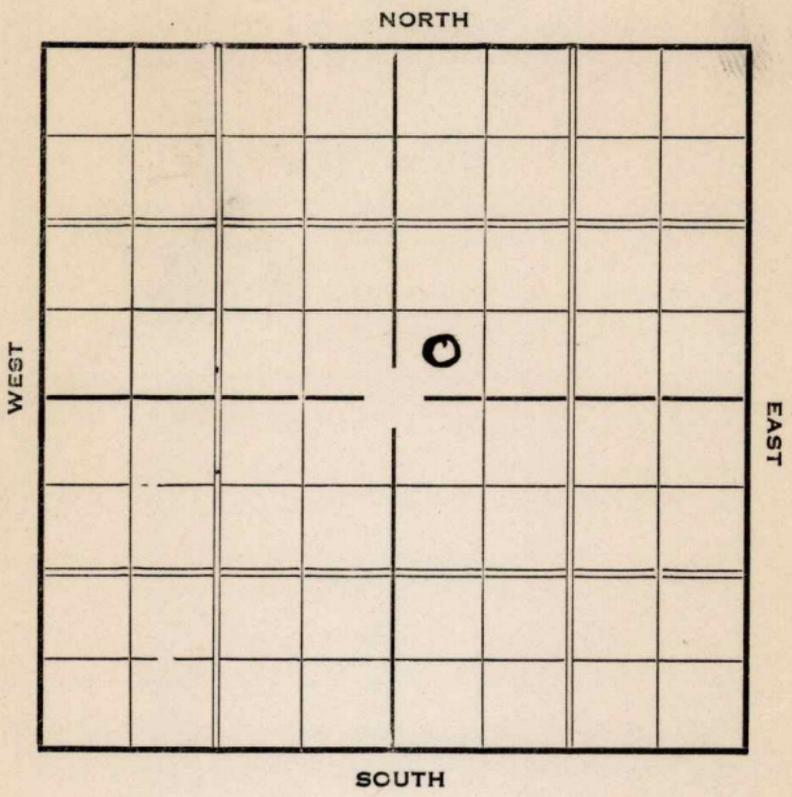

Sec. 4 Twp. 12 R. 17-W

Well No. #1 Bemis "A" Farm

~~Wolfe Creek et al~~ Company


T. M. Deal

_____ Ft. from N. Line

330 Ft. from S. Line

_____ Ft. from E. Line

330 Ft. from W. Line

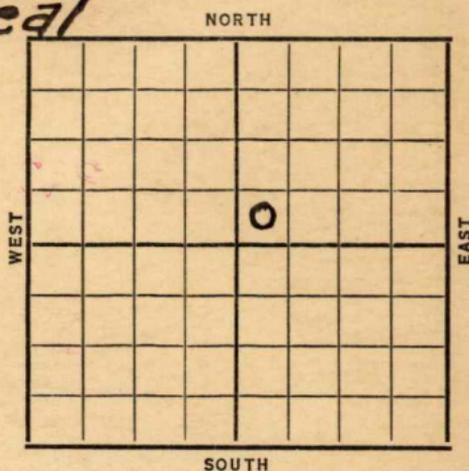

Elev. 2051

Date	REPORT
1937	
3/31	Location
4/8	" "
4/16	Rig
4/23	Rigging up
4/30	12" @ 1078'.
	T.D. 1079'. WOC.
5/7	Drlg. 2210'.
5/12	Anhy 1253'. Drlg. 3168'.
5/21	Sil. 3560-68' T.D.
	8" @ 3561'.
	Saturated Core 3563-68'.
5/28	T.D. 3568'. 8" pipe
	collapsed.
6/4	Shut down.
6/11	" "
6/19	" "
6/25	" "
7/2	" "
7/9	7" @ 3560'. WOC.

OVER

1937

- 7/16 7" @ 3530' (Corrected)
T.D. 3572'. 1000 acid.
Bailing 8 bbls. per hr.
Will reacidize.
- 7/23 Reacidized 1000 gal.
- 7/30 Potential 1100 bbls. 24 hrs.
Retesting.

8/4 7" @ 3560'
Sil 3560'
TD 3572'
2000 acid
Pot 1114

COMPLETED

Map No. _____ Sec. 4 Twp. 12 R. 17W

Well No. 1 Bemis "A"

Wolfe Creek & Co. Company

Contractor

SECTION PLAT

		0	

_____ Ft. from N. Line

330 Ft. from S. Line

_____ Ft. from E. Line

330 Ft. from W. Line

FIRST REPORT

Location _____

Rig up _____

Drilling and Remarks:

RECORD

Cased _____ in., _____ ft.

Sand _____

Gas _____

Oil _____

Total Depth _____

PRODUCTION

1st 24 hrs. Nat. _____

1st 24 hrs. after shot _____

Gas _____ Cu. Ft.

Dry Hole _____

Abandoned _____

Date

MAR 31 1937 19

S. J. LEWIS Scout

Map No. _____ Sec. 4 Twp. 12 R. 17W.

Well No. 1 Benis "a"

T. M. Deal Company

Contractor

SECTION PLAT

		o	

_____ Ft. from N. Line

380 Ft. from S. Line

_____ Ft. from E. Line

380 Ft. from W. Line

CORRECTION

Location _____

Rig up _____

Drilling and Remarks:

*Reported as
Wolf Creek & Deal
should be T.M.
Deal.*

RECORD

Cased _____ in., _____ ft.

Sand _____

Gas _____

Oil _____

Total Depth _____

PRODUCTION

1st 24 hrs. Nat. _____

1st 24 hrs. after shot _____

Gas _____ Cu. Ft.

Dry Hole _____

Abandoned _____

Date

APR 14 1937

19

S. J. LEWIS

Scout

Ellis **KANSAS**

Map No. _____ Sec. 4 Twp. 12 R. 17^w

Well No. 1 - Bemis "A"

T. M. Deal Company

Contractor

COMPLETED

SECTION PLAT

_____ Ft. from N. Line

330 Ft. from S. Line

_____ Ft. from E. Line

330 Ft. from W. Line

		0	

Location _____

Rig up _____

Drilling and Remarks:

2000 Acid

Pot - 1114

RECORD

Cased 7 in., 3560 ft.

Sand 511 3560

Gas _____

Oil _____

Total Depth 3572

PRODUCTION

1st 24 hrs. Nat. _____

1st 24 hrs. after shot _____

Gas _____ Cu. Ft.

Dry Hole _____

Abandoned _____

Date

AUG 4 1937

H. D. Hatfield Scout