


Section 4 Township 12 Range 17W

Well No. ~~4 Bemis~~ #2 Bemis "A"

Company Wolfe Creek

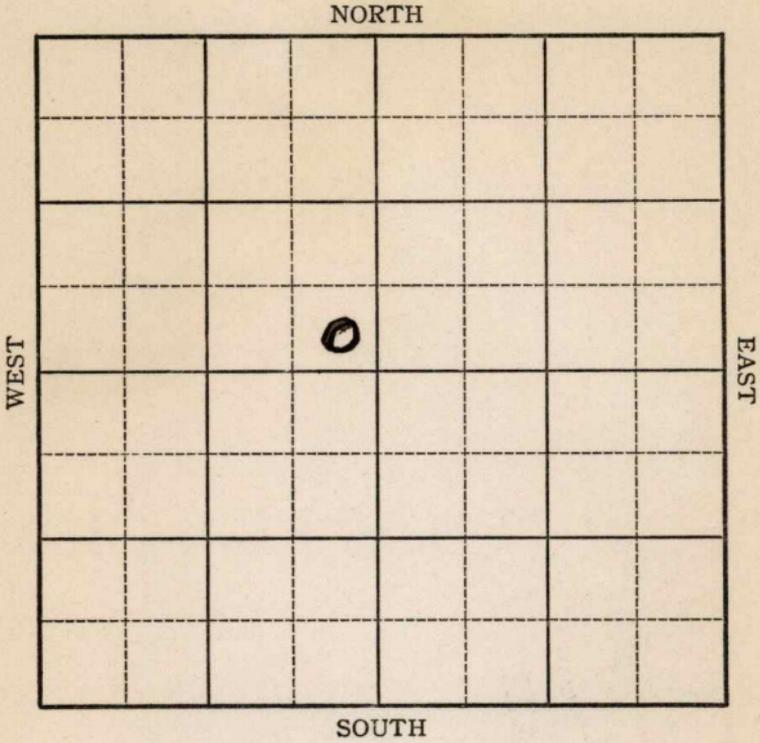

KANSAS

Ellis

Sec. 4 Twp. 12 R. 17-W

Well No. ~~#~~ Bemis # 2-A Farm


Wolfe Creek Company

_____ Ft. from N. Line

330 Ft. from S. Line

330 Ft. from E. Line

_____ Ft. from W. Line

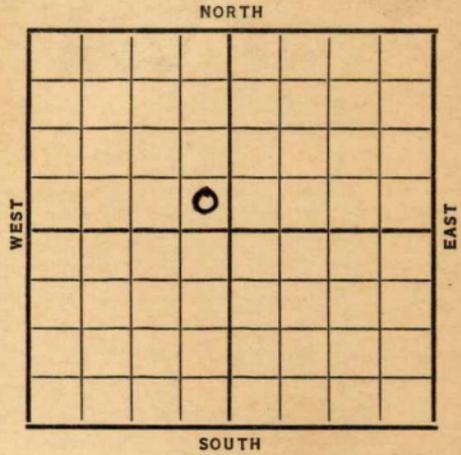

Date	REPORT
1937	
7/28	R. R.
8/6	10" @ 1053'. WOC.
8/13	Drlg. 2770'.
8/20	Drlg. 3560'.
	K.C. 3327'
	B.K.C. 3599'
	Simp 3690'
	Sil 3715-20' S.W.
	TD 3720'
	D&A
	ABANDONED

Ellis KANSAS

Map No. _____ Sec. 4 Twp. 12 R. 17^w

Well No. 4 - Bemis

Wolfe Creek Company _____
Contractor _____

FIRST REPORT

SECTION PLAT

_____ Ft. from N. Line

330 Ft. from S. Line

330 Ft. from E. Line

_____ Ft. from W. Line

		0	

Location _____

Rig up _____

Drilling and Remarks:

R.R.

RECORD

Cased _____ in., _____ ft.

Sand _____

Gas _____

Oil _____

Total Depth _____

PRODUCTION

1st 24 hrs. Nat. _____

1st 24 hrs. after shot _____

Gas _____ Cu. Ft.

Dry Hole _____

Abandoned _____

Date

JUL 28 1937

19

H. D. Hatfield

Scout

Ellis KANSAS

Map No. 71 Sec. 4 Twp. 12 R. 17^w


Well No. 2-Bemis "A"

Wolfe Creek Company

Contractor

CORRECTION

SECTION PLAT

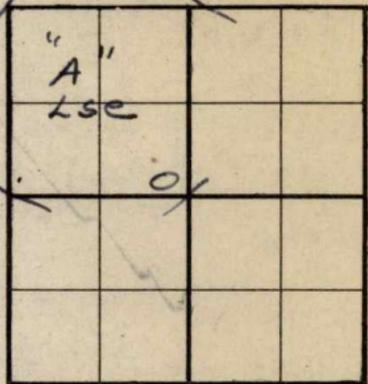

_____ Ft. from N. Line

330 Ft. from S. Line

330 Ft. from E. Line

_____ Ft. from W. Line

Location _____

Rig up _____

Drilling and Remarks:

*first reported
as # 4 - Bemis*

RECORD

Cased _____ in., _____ ft.

Sand _____

Gas _____

Oil _____

Total Depth _____

PRODUCTION

1st 24 hrs. Nat. _____

1st 24 hrs. after shot _____

Gas _____ Cu. Ft.

Dry Hole _____

Abandoned _____

Date

AUG 11 1937 19

H. D. Hatfield

Scout

Ellis **KANSAS**

Map No. _____ Sec. 4 Twp. 12 R. 17^w

Well No. 2-Bemis "A"

Walfe Creek Company _____

Contractor _____

ABANDONED

SECTION PLAT

		0	

_____ Ft. from N. Line

330 Ft. from S. Line

330 Ft. from E. Line

_____ Ft. from W. Line

Location _____

Rig up _____

Drilling and Remarks:

K.C. 3327
B.K.C. 3599
Simp 3690
sil 3715-20 SW

D & A

RECORD

Cased _____ in., _____ ft.

Sand 511 3715

Gas _____

Oil _____

Total Depth 3720

PRODUCTION

1st 24 hrs. Nat. _____

1st 24 hrs. after shot _____

Gas _____ Cu. Ft.

Dry Hole _____

Abandoned _____

Date

AUG 25 1937 19

H. D. Hatfield Scout