

Map No. Kansas Sec. 9 Twp. 33 R. 3-E


Well No. 1-Graham Farm
~~Peters~~ Company
DUFFIELD

990 Ft. from N. Line

_____ Ft. from S. Line

_____ Ft. from E. Line

990
~~330~~ Ft. from W. Line

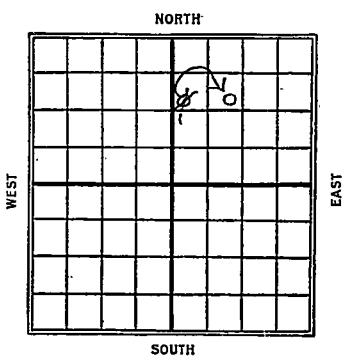

1926.

Date REPORT

<u>4/21</u>	<u>Location</u>
<u>4/29</u>	<u>_____</u>
<u>5/5</u>	<u>Same.</u>
<u>5/12</u>	<u>Rig Bldg.</u>
<u>5/19</u>	<u>Rigging up.</u>
<u>5/26</u>	<u>Rigging up.</u>
<u>6/2</u>	<u>Trig 510</u>
<u>6/9</u>	<u>" 1660 H.F.W.</u>
<u>6/16</u>	<u>" 2025</u>
<u>6/23</u>	<u>" 2100</u>
<u>6/30</u>	<u>TD 2325 U.P. 6"</u>
<u>7/14</u>	<u>H.F.W. 2534-47 - T.D. 2547</u>
	<u>D & A</u>

Country
Map No. **14119** Sec. 9 Twp. 33 R. 3E

Well No. 1 Graham

A. R. Peters Company

Contractor

SECTION PLAT

		0	

990 Ft. from N. Line

_____ Ft. from S. Line

3 Ft. from E. Line

330 Ft. from W. Line

FIRST REPORTS

Location _____

Rig up _____

Drilling and Remarks:

Location.

RECORD

Cased _____ in., _____ ft.

Sand _____

Gas _____

Oil _____

Total Depth _____

PRODUCTION

1st 24 hrs. Nat. _____

1st 24 hrs. after shot _____

Gas _____ Cu. Ft.

Dry Hole _____

Abandoned _____

Date

APR 20 1926

S. J. LEWIS

Scout

Map No. KANSAS Sec. 9 Twp. 33 R. 3E

Well No. 1 Graham

Thuffield Company

Contractor


SECTION PLAT

990 Ft. from N. Line

_____ Ft. from S. Line

_____ Ft. from E. Line

990 Ft. from W. Line

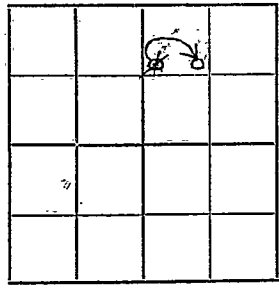

Correction.

Location _____

Rig up _____

Drilling and Remarks:

Thuffield is going to drill this change the location from SW. NW. NE to SE. NW. NE.

RECORD

Cased _____ in., _____ ft.

Sand _____

Gas _____

Oil _____

Total Depth _____

PRODUCTION

1st 24 hrs. Nat. _____

1st 24 hrs. after shot _____

Gas _____ Cu. Ft.

Dry Hole _____

Abandoned _____

Date

MAY 12 1926

S. J. LEWIS

192

Scout

K1 Cowley.
 Map No. **KANSAS** Sec. *9* Twp. *33* R. *3E*

Well No. *1 Graham*

Duffield & Dal Company

Contractor

SECTION PLAT

990 Ft. from N. Line

_____ Ft. from S. Line

_____ Ft. from E. Line

990 Ft. from W. Line

		0	

ABANDONED

Location _____

Rig up _____

Drilling and Remarks:

HFV 2034 & 47

TD 2047

D & A

RECORD

Cased _____ in., _____ ft.

Sand _____

Gas _____

Oil _____

Total Depth _____

PRODUCTION

1st 24 hrs. Nat. _____

1st 24 hrs. after shot _____

Gas _____ Cu. Ft.

Dry Hole _____

Abandoned _____

Date

JUL 14 1926

192

S. J. LEWIS

Scout

MAP No. _____ SEC. 9 TWP. 33S 3E R. 3E

WELL No. 1 Graham
Peters & Duffield COMPANY

CONTRACTOR _____

SECTION PLAT

		0	

_____ FT. FROM N. LINE

_____ FT. FROM S. LINE

_____ FT. FROM E. LINE

_____ FT. FROM W. LINE

LOCATION _____

RIG UP _____

DRILLING AND REMARKS:

H.Z. W. M.

RECORD

CASED _____ IN. _____ FT.

SAND _____

GAS _____

OIL _____

TOTAL DEPTH. 2547

PRODUCTION

1ST 24 HRS. NAT. _____

1ST 24 HRS. AFTER SHOT _____

GAS _____ CU. FT.

DRY HOLE

ABANDONED

DATE

7/14 1926

SCOUT