


Map No. K. Sec. 9 Twp. 33 R. 3

Well No. 2 Graham Farm
Alcorn Company

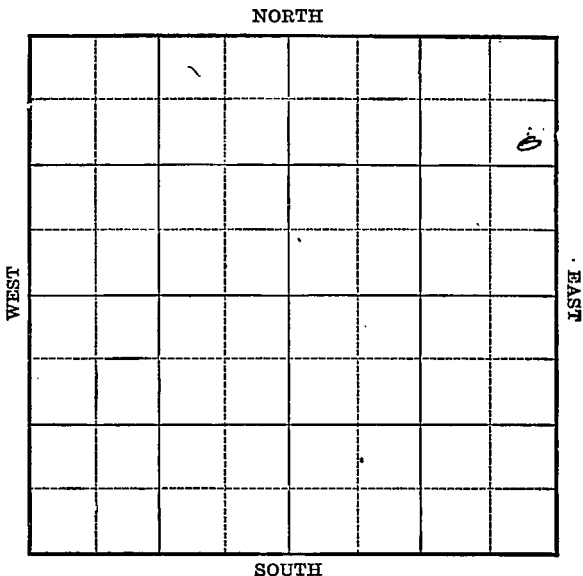

Location _____

Drilling Remarks:

Rig Up _____

Drilling Remarks:

RECORD

Cased _____ in. _____ ft.

Sand _____

Gas _____

Oil _____

Total Depth _____

PRODUCTION

1st 24 hrs. Nat. _____

1st 24 hrs. after shot _____

Gas _____ cu. ft.

Dry Hole _____

Abandoned _____

Map No. 7 Sec. 9 Twp. 33 R. 3


Well No. 2 Galum Farm
Alcorn Company

940 Ft. from N. Line

_____ Ft. from S. Line

300 Ft. from E. Line

_____ Ft. from W. Line

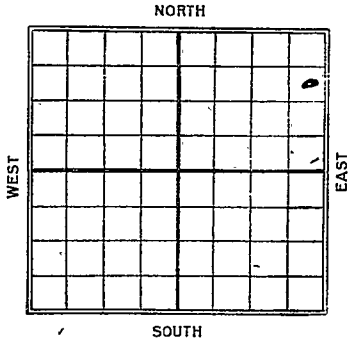

Date	REPORT
1924	
8/26	Location
10/28	spud.
11/26	Sh 2407'
12/11	Sand 2558-64
	Swabbing 232 Bbls
	Shot 40 gts 160 Bbls
	Pumping

KI *SAS.*
 Map No. _____ Sec. *9* Twp. *33* R. *3*
 Well No. *2 Graham*
Allyn _____ Company

_____ Contractor

FIRST REPORT

SECTION PLAT

990 Ft. from N. Line
 _____ Ft. from S. Line
300 Ft. from E. Line
 _____ Ft. from W. Line

			0

Location *← ←* _____
 Rig up _____
 Drilling and Remarks: _____

RECORD

Cased _____ in., _____ ft.
 Sand _____
 Gas _____
 Oil _____
 Total Depth _____

PRODUCTION

1st 24 hrs. Nat. _____
 1st 24 hrs. after shot _____
 Gas _____ Cu. Ft.
 Dry Hole _____
 Abandoned _____

Date
AUG 25 1924

M. A. BENEAR

Scout

Map No. ~~112543~~ Sec. 9 Twp. 33 R. 3

Well No. 2 Graham

Alvord Oil Company

Contractor

SECTION PLAT
COMPLETE

990 Ft. from N. Line

_____ Ft. from S. Line

300 Ft. from E. Line

_____ Ft. from W. Line

			0

Location _____

Rig up _____

Drilling and Remarks:

*Sand 2558-64
swabbing 232 lbs
shot 40/160 lbs
pumping*

RECORD

Cased _____ in., _____ ft.

Sand _____

Gas _____

Oil _____

Total Depth _____

PRODUCTION

1st 24 hrs. Nat. _____

1st 24 hrs. after shot _____

Gas _____ Cu. Ft.

Dry Hole _____

Abandoned _____

Date **DEC 11 1924**

M. A. BENEAR

_____ 192_____

_____ Scout