

Ellis


KANSAS

Form 51-5M 5-37 Petrol

Section 4 Township 12 Range 17-W

Well No. 3 Bemis "A"


Company Wolfe Creek

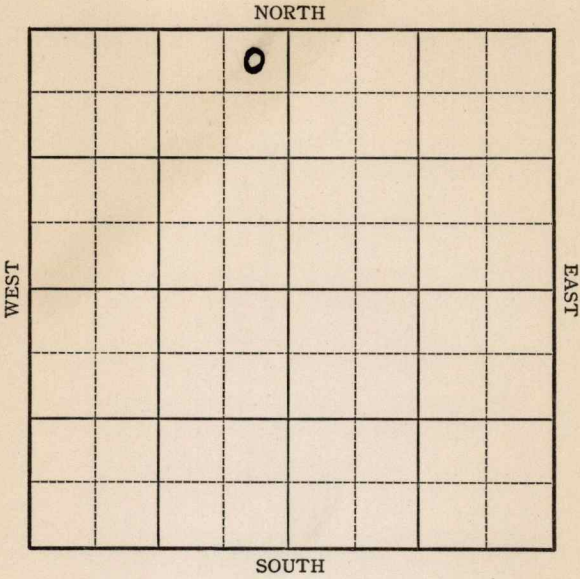

Sec. 4 Twp. 12 R. 17-W

Well No. #3 Bemis "A" Farm
Wolfe Creek Company

330 Ft. from N. Line
 _____ Ft. from S. Line
330 Ft. from E. Line
 _____ Ft. from W. Line

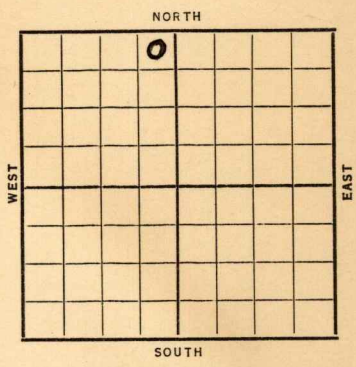

Elev. 2059

Date	REPORT
1937	
10/6	R U R
10/15	10" @ 998'. Drlg. 1320'.
10/22	Drlg. 2880'.
10/29	Sil. & 7" @ 3557'.
	T.D. 3560'. S.O. RUST.
11/5	T.D. 3568'. 2500' oil.
11/10-	7" @ 3557'.
	Sil. 3557'.
	T.D. 3568'.
	5000 acid.
	Potential 1351 bbls.
	COMPLETED

Ellis **KANSAS**

Map No. _____ Sec. 4 Twp. 12 R. 17W

Well No. 3 Bemis "A"

Wolf Creek Oil Company

Contractor _____

COMPLETED

NE NW

330 Ft. from N. Line

_____ Ft. from S. Line

330 Ft. from E. Line

_____ Ft. from W. Line

SECTION PLAT

	0		

Location _____

Rig up _____

Drilling and Remarks:

5000 acid

POT-1351

RECORD

Cased 7 in., 3557 ft.

Sand sil 3557

Gas _____

Oil _____

Total Depth 3568

PRODUCTION

1st 24 hrs. Nat. _____

1st 24 hrs. after shot _____

Gas _____ Cu. Ft.

Dry Hole _____

Abandoned _____

Date

NOV 10 1937 19 _____

H. D. Hatfield Scout

Ellis

KANSAS

Map No. _____ Sec. 4 Twp. 12 R. 17W

Well No. 3 Bemis "A"

Wolfe Creek Company _____

Contractor _____

FIRST REPORT

SECTION PLAT

NE NW

330 Ft. from N. Line

_____ Ft. from S. Line

330 Ft. from E. Line

_____ Ft. from W. Line

	0		

Location _____

Rig up _____

Drilling and Remarks:

RUR

RECORD

Cased _____ in., _____ ft.

Sand _____

Gas _____

Oil _____

Total Depth _____

PRODUCTION

1st 24 hrs. Nat. _____

1st 24 hrs. after shot _____

Gas _____ Cu. Ft.

Dry Hole _____

Abandoned _____

Date

H. D. Hatfield

OCT - 6 1937 19

Scout