


Section 4 Township 12 Range 17-W

Well No. #1 Bemis "B"

Company Wolfe Creek

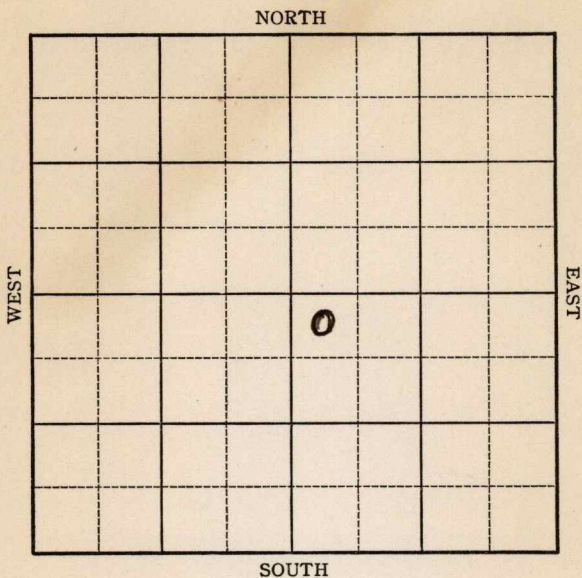

1937

11/26 T.D. 3633'. S.O. & W.
P.B. 3503'. Perforated
pipe 3350-94'. C.O.

12/3 Dodge 3305'. K.C. 3328'.
Cong. 3570'. Simp. 3615'.
5000 acid.

12/8 7" @ 3568'.
Sil. 3616'.
T.D. 3663' S.O. & W.
P.B. 3503'.
Perforated pipe.
5000 acid.
No help.

ABANDONED

Ellis KANSAS

Map No. _____ Sec. 4 Twp. 12 R. 17^WWell No. 1-Bemis "B"Wolfe Creek Company _____

Contractor _____


FIRST REPORT

SECTION PLAT

330 Ft. from N. Line

_____ Ft. from S. Line

_____ Ft. from E. Line

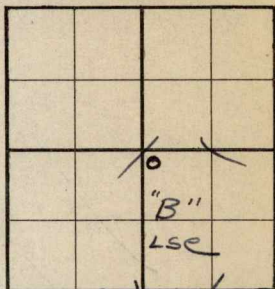330 Ft. from W. Line

Location _____

Rig up _____

Drilling and Remarks:

Cellar

RECORD

Cased _____ in., _____ ft.

Sand _____

Gas _____

Oil _____

Total Depth _____

PRODUCTION

1st 24 hrs. Nat. _____

1st 24 hrs. after shot _____

Gas _____ Cu. Ft.

Dry Hole _____

Abandoned _____

Date

AUG 11 1937 19

H. D. Hatfield Scout

Ellis

KANSAS

Map No. _____ Sec. 4 Twp. 12 R. 17WWell No. 1 Bemis "B"Wolfe Creek

Company _____

Contractor _____

ABANDONED

SECTION PLAT

		0	

NW SE

330 Ft. from N. Line

_____ Ft. from S. Line

_____ Ft. from E. Line

330 Ft. from W. Line

Location _____

Rig up _____

Drilling and Remarks:

P.B. 3503
Perforated pipe
5000 Acid
No help
D & A

RECORD

Cased 7 in. 3568 ft.Sand 511 3616

Gas _____

Oil _____

Total Depth 366350.4w.

PRODUCTION

1st 24 hrs. Nat. _____

1st 24 hrs. after shot _____

Gas _____ Cu. Ft.

Dry Hole _____

Abandoned _____

Date

DEC 8 - 1937

19

H. D. Hatfield

Scout