FORM 51 10M 8-47


KANSAS

Ellis

Section 4 Township 12 Range 17W

Well No. 5 Bemis "I"

Company Sohio

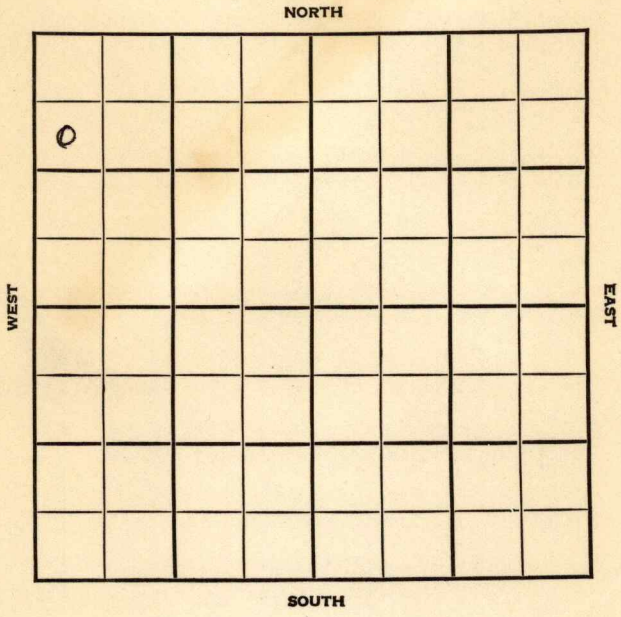

FORM 252-A
5M 4-48 PETROL

KANSAS Ellis V

Sec. 4 Twp. 12 R. 17W

Well No. #5 Bemis "I" Farm

Sohio Company

Cayons


990 Ft. from N. Line

Ft. from S. Line

Ft. from E. Line

330 Ft. from W. Line

SW NW NW

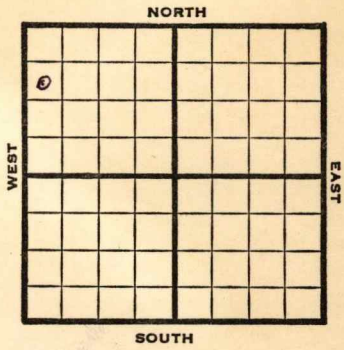

1948	Elev. 2021' REPORT
4/28	RUR
5/5	Surface hole.
5/12	8" @ 1246' Drlg. 3115'
5/19	Heebner 3174' Dodge 3192' Lansing 3219' BKC 3439' Arbuckle 3472' TD 3481' 5" @ 3473' RUST
5/26	Arbuckle 3472' 5" @ 3473' Pump 40 oil Pot. Gr. 29° TD 3481' COMPLETED

Form 26—200 Bks.—1-48—Palace

Kansas

Cayons Pool

Map No._____ Sec. 4 Twp. 12 R. 17W

Well No. 5 Bemis "I"

Sohio Company

FIRST REPORT Contractor

SW NW NW

990 Ft. from N. Line


_____ Ft. from S. Line

_____ Ft. from E. Line

330 Ft. from W. Line

Ellis County

SECTION PLAT

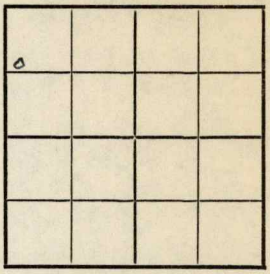

Location_____

Rig up_____

Drilling and Remarks:

R U R

RECORD

Cased_____ in., _____ ft.

Sand_____

Gas_____

Oil_____

Total Depth_____

PRODUCTION

1st 24 hrs. Nat._____

1st 24 hrs. after shot_____

Gas_____ Cu. Ft.

Dry Hole_____

Abandoned_____

Date

APR 2 8 1948 19____ S. J. LEWIS Scout

Form 26—200 Bks.—1-48—Palace

Kansas

Cayons Pool

Map No. 71 Sec. 4 Twp. 12 R. 17W

Well No. 5 Bemis "I"


Sohio Company

COMPLETE Contractor

SW NW NW

El. 2021

SECTION PLAT

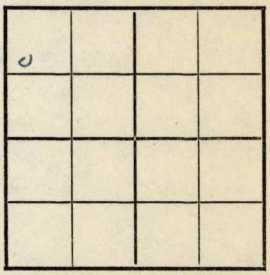

990 Ft. from N. Line

Ft. from S. Line

Ft. from E. Line

330 Ft. from W. Line

Ellis County

Location

Rig up

Drilling and Remarks:

RECORD

Cased in., ft.

Sand

Gas

Oil ✓

Total Depth 3487

PRODUCTION

1st 24 hrs. Nat.

1st 24 hrs. after shot

Gas Cu. Ft.

Dry Hole

Abandoned

Date

MAY 26 1948 19 S. J. LEWIS Scout