



KANSAS

Map No. \_\_\_\_\_ Sec. 4 Twp. 12 R. 17-W

Well No. 1-Dreiling Farm \_\_\_\_\_

Wolfe Creek Company \_\_\_\_\_


330 Ft. from N. Line

\_\_\_\_\_ Ft. from S. Line

\_\_\_\_\_ Ft. from E. Line

330 Ft. from W. Line

Elev. 2059

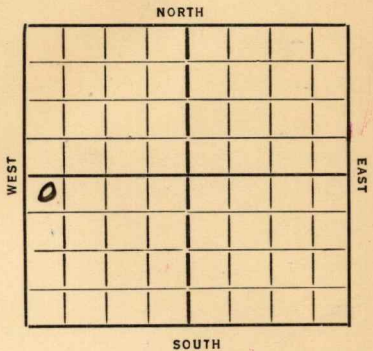

REPORT

O. W. D. D

Date	REPORT
1936	
4/1	Building rig
4/10	--
4/16	Rig.
4/23	-- 4/30--
5/7	Rigging up.
5/14	Drlg. 295'.
5/21	745'. 15" @ 535'.
5/28	1100' Fishing.
6/4	-- 6/11-- 6/18-- <del>6/25</del>
6/25	Shut down.
7/2	10" @ 1064'. Drlg. 1105'.
7/9	10" @ 1100'. Cleaning out.
7/16	--
7/23	Drlg. 1300'.
7/30	Drlg. 1535'.
8/6	1555'. Fishing.
8/13	Shut down.
8/20	--
8/27	10" @ 1293'. TD 1595'. Shut down.
9/3	8" @ 1591'. Drlg. 2085'.
9/10	8" @ 2319'. Drlg. 2320'.

OVER

9/18-2528'. under ream 8".  
9/24-2585' shut down.  
10/1-2695' fishing under reamer lugs.  
10/8-8" @ 2803'. Drlg. 2806'.  
10/15-8" @ 2876'. Drlg. 2894'.  
~~10/22-8" @ 2892'. Drlg. 2942'.~~  
10/29-Drlg. 3065'.  
11/6-8" @ 3016 Topeka 3042 6" @ 3262  
Lansing 3280 Show oil 3280-85  
Show oil 3300-11 Drlg.  
11/12--Oswald 3300'. Set 6" @ 3300  
oil 3311-15 T. D. 3347'  
1600' oil in hole.  
11/19--T. D. 3350'.  
11/25 Oswald 3300'. T. D. 3350'.  
2500 acid. Pump 376-Pot.

COMPLETED.

O. W. D. D

1937

3/31 Sil. 3526'.  
T.D. 3531'.  
Potential 1297 Natural.

FIRST REPORT.

*and*  
COMPLETED

KANSAS

Map No. 71  
Sec. 4  
Twp. 12 R. 17n  
Well No. 1 - Bleeding  
Morse Creek  
Company \_\_\_\_\_  
Contractor \_\_\_\_\_

FIRST REPORTS


330 Ft. from N. Line  
Ft. from S. Line  
Ft. from E. Line  
330 Ft. from W. Line

SECTION PLAT

Location \_\_\_\_\_

Rig up \_\_\_\_\_

Drilling and Remarks: *Berry King*

---

RECORD

Cased \_\_\_\_\_ in, \_\_\_\_\_ ft.

Sand \_\_\_\_\_

Gas \_\_\_\_\_

Oil \_\_\_\_\_

Total Depth \_\_\_\_\_

---

PRODUCTION

1st 24 hrs. Nat. \_\_\_\_\_

1st 24 hrs. after shot \_\_\_\_\_

Gas \_\_\_\_\_ Cu. Ft.

Dry Hole \_\_\_\_\_

Abandoned \_\_\_\_\_

Date \_\_\_\_\_  
11-1-36  
192  
ORVAL MANNSCHECK  
Scout

Map No. 71 Sec. 4 Twp. 12 R. 17W

Well No. 12 P. Dressing

Hoffe Creek Company

Contractor

**SECTION PLAT**

330 Ft. from N. Line

\_\_\_\_\_ Ft. from S. Line

\_\_\_\_\_ Ft. from E. Line

330 Ft. from W. Line

0			

**COMPLETED**

Location \_\_\_\_\_

Rig up \_\_\_\_\_

Drilling and Remarks:

Oswal 9800

2500 acid

Pump 376 P.D.

**RECORD**

Cased \_\_\_\_\_ in., \_\_\_\_\_ ft.

Sand \_\_\_\_\_

Gas \_\_\_\_\_

Oil \_\_\_\_\_

Total Depth 3350

**PRODUCTION**

1st 24 hrs. Nat. \_\_\_\_\_

1st 24 hrs. after shot \_\_\_\_\_

Gas \_\_\_\_\_ Cu. Ft.

Dry Hole \_\_\_\_\_

Abandoned \_\_\_\_\_

Date

NOV 25 1936 19

**S. J. LEWIS**

Scout

Map No. \_\_\_\_\_ Sec. 4 Twp. 12 R. 17W

Well No. 1 Drilling

Wolfe Creek & Co Company

Contractor

**SECTION PLAT**

330 Ft. from N. Line

330 Ft. from S. Line

\_\_\_\_\_ Ft. from E. Line

330 Ft. from W. Line

FIRST REPORT

COMPLETED

*D.W.D.*

0			

Location \_\_\_\_\_

Rig up \_\_\_\_\_

Drilling and Remarks:

*Sil 3526*

*Potential*

*1297 natural*

**RECORD**

Cased \_\_\_\_\_ in., \_\_\_\_\_ ft.

Sand \_\_\_\_\_

Gas \_\_\_\_\_

Oil \_\_\_\_\_

Total Depth 3531

**PRODUCTION**

1st 24 hrs. Nat. \_\_\_\_\_

1st 24 hrs. after shot \_\_\_\_\_

Gas \_\_\_\_\_ Cu. Ft.

Dry Hole \_\_\_\_\_

Abandoned \_\_\_\_\_

Date

MAR 31 1937

19

S. J. LEWIS Scout