


Section 4 Township 12 Range 17W

Well No. 1 Dreiling

Company Walters Drlg.

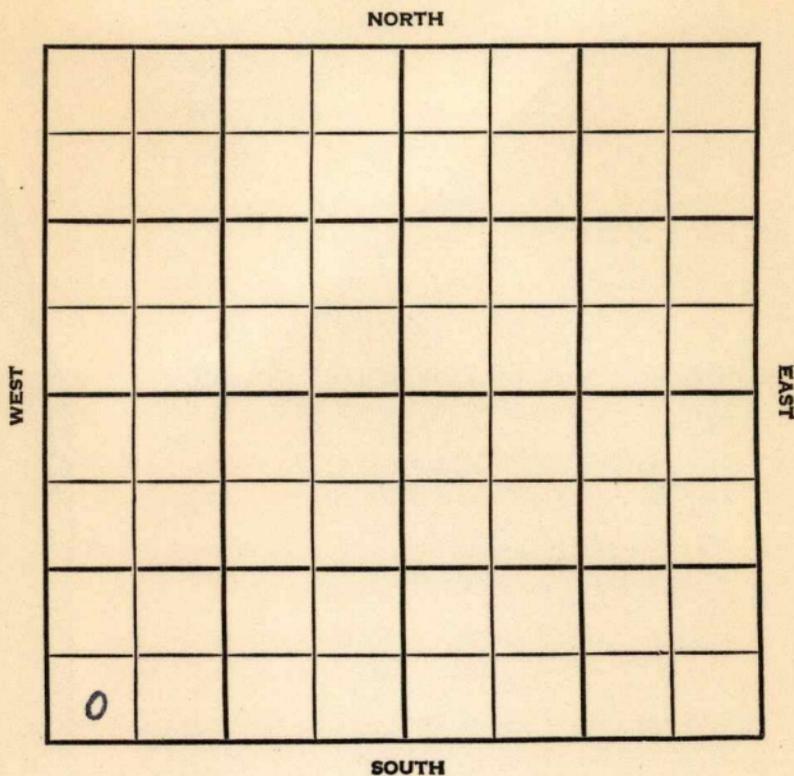

Ellis

KANSAS


SEC.	4	TWP.	12	R.	17W
------	---	------	----	----	-----

WELL NO. #1 Dreiling FARM

COMPANY Walters Drlg.

CONTRACTOR Co. Tools.

_____ Ft. from N. Line
 330 _____ Ft. from S. Line
 _____ Ft. from E. Line
 330 _____ Ft. from W. Line

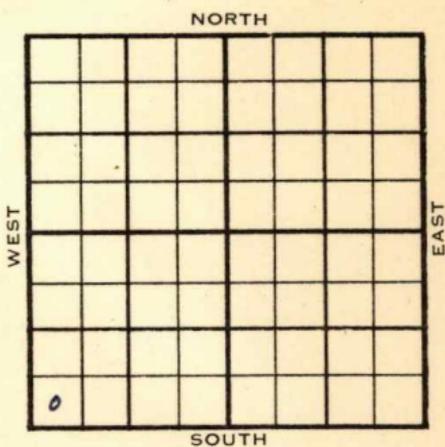

SW SW SW
 Sohio F/0

	ELEVATION	REPORT
1955	2118'	

2/2 Spud 1-27-55
 8" @ 151'

Anhy 1345'

2/16 Drlg. 1748'
 Spud 1-27-55
 D & A

TD 3690'

8" @ 151'

Anhy 1345' Heeb. 3320' Tor. 3341'

Lans 3368' Cong. 3624' Simp 3634'

Arb. 3658'

TD 3690'

D & A

ABANDONED

