



Ellis

KANSAS

SEC.	TWP.	R.
34	13	16 W

WELL NO. # 1 Braun "D" FARM

COMPANY Elreco

CONTRACTOR

Wildcat


330 Ft. from N. Line

Ft. from S. Line

Ft. from E. Line

990 Ft. from W. Line

NE NW SW

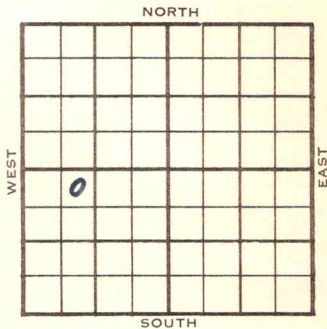

1953	ELEVATION	REPORT
------	-----------	--------

1953	1956'	
9/23	8" @ 323 Drlg. 460'	
9/30	Heeb 3163, Tor 3182', Lans 3205 DST 3193'-3223' 1/2 hr, 5' M Drlg 3315'	
10/7	Cong 3457' DST 3457-68, 1 hr, 745' oil, 30' OCM 955# RTD 3530' 5" @ 3530 CO 3517 6/3474-80 3 BWPH PB 3471 7/3459-66 S/8 BOPH 13 hrs.	
10/14	NR	
10/21	NR	
11/4	Spud 9-20-53 Oil well TD 3530 8" @ 323 Heeb 3153 Tor. 3172 Lans. 3195 DST 3183-3213 open 1/2 hr rec 5' mud Cong. 3457 DST 3457-68 open 1 hr rec 745' oil 30' OCM 955# TD 3530 5" @ 3530 CO to 3517 6/3474-80 3 BWPH 1 hr. PB 3471 7/3459-66 S/8 BOPH 13 hr. Comp. 240 BOPD	

COMPLETED


County Ellis State Kansas

Sec. 34 (Blk. 13) (Sur. Rge.) 16W Map No.

Operator Elreco

Well No. 1 Farm Braun "D"

Elev. \_\_\_\_\_ Location NE NW SW

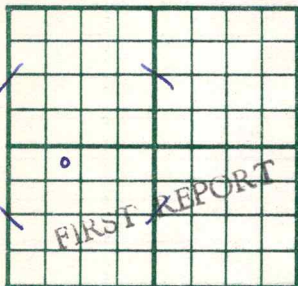

330 Ft. From N Line SW

990 Ft. From W Line Quarter

1st. Report SEP 23 1953

Completion \_\_\_\_\_

Remarks \_\_\_\_\_

Spudding Date \_\_\_\_\_

Drlg. Data Wildcat

8" @ 323 drlg. 460


County Ellis State Kansas

Sec. 34 (Blk. 13 (Sur. 16W Map No. 13) (Twp. 13) (Rge. 16W)

Operator Elreco

Well No. 1 Farm Braun "D"

Elev. 1956 Location NE NW SW

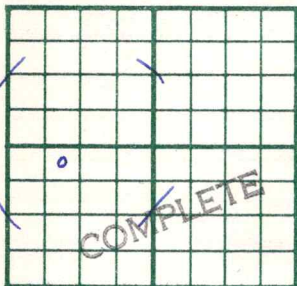

330 Ft. From N Line SW

990 Ft. From W Line Quarter

1st. Report \_\_\_\_\_

Completion NOV 4 1953

Remarks \_\_\_\_\_

Wildcat

Spudding Date 9-20-53

Drig. Data Oil well TD 3530

8" @ 323 Heeb. 3153 Tor. 3172

Lans. 3195 DST 3183-3213 open  $\frac{1}{2}$  hr.

Rec. 5' mud Cong. 3457 DST 3457-68

open 1 hr. Rec. 745' oil 30' ocm

955# TD 3530 5" @ 3530 CO to 3517

6/ 3474-80 3 bwph 1 hr. PB 3471

7/ 3459-66 S/ 8 boph 13 hr.

Comp. 240 bopd