

KANSAS


Ellis County

FORM 51 25M 3-49 PETROL

Section 22 Township 12 Range 16-W

Well No. #1 Ginther

Company Cities Service

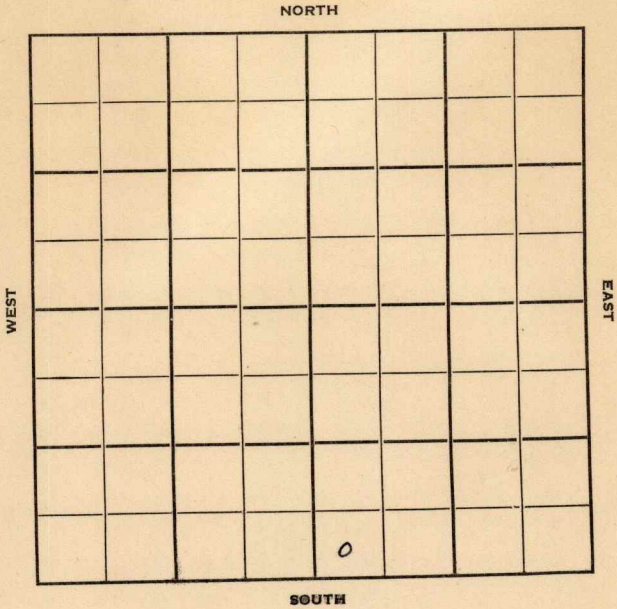

Sec. 22 Twp. 12 R. 16W

Well No. #1 Ginther Farm

Cities Service Company

Lohman & Johnson Contractor

Christina Pool


Ft. from N. Line

330' Ft. from S. Line

Ft. from E. Line

330' Ft. from W. Line

SW SW SE

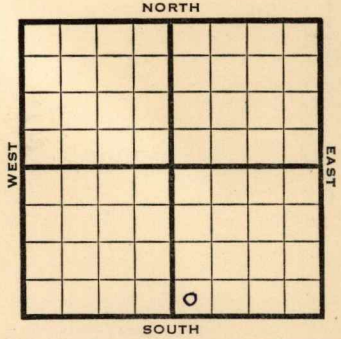

1950

Elev 1984' REPORT

2/15

Spud 2-9-50
8" @ 255'

4/19

Drlg. 2090'
TD 3474'
8" @ 255'
Topeka 2887'
Lans 3193'
Arb. 3466'
5" @ 3468'
Plug back to 3421'
P 42 BOPD
Gomp

COMPLETED

Map No. _____ Sec. 22 Twp. 12 R. 16W

Well No. 1 Ginther


Cities Service

Company

Contractor

SW SW SE

EI. 1984
SECTION PLAT

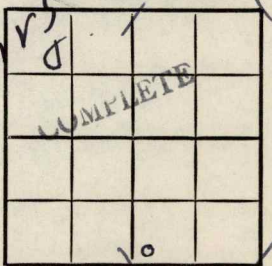

Ft. from N. Line

330

Ft. from S. Line

Ft. from E. Line

330

Ft. from W. Line

Ellis County

Location _____

Rig up _____

Drilling and Remarks:

8" @ 255
Topeka 2887
Lans 3193
and 3466
5" @ 3468
Plug back to 3421
42 BOPD

RECORD

Cased _____ in., _____ ft.

Sand _____

Gas _____

Oil _____

Total Depth 3474

PRODUCTION

1st 24 hrs. Nat. _____

1st 24 hrs. after shot _____

Gas _____ Cu. Ft.

Dry Hole _____

Abandoned _____

Date

APR 19 1950 19

J. E. TYRA Scout

Map No. _____ Sec. 22 Twp. 12 R. 16W


Well No. 1 Ginther

Cities Service Company

Lohman & Johnson Contractor

SW SW SE

SECTION PLAT

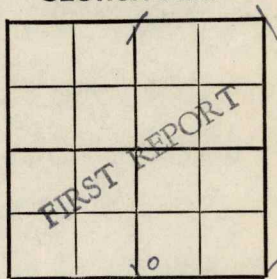

_____ Ft. from N. Line

330

_____ Ft. from S. Line

_____ Ft. from E. Line

330

_____ Ft. from W. Line

Ellis County

Location _____

Rig up _____

Drilling and Remarks:

Spud 2-9-50

8" @ 255

drlg. 2090

RECORD

Cased _____ in., _____ ft.

Sand _____

Gas _____

Oil _____

Total Depth _____

PRODUCTION

1st 24 hrs. Nat. _____

1st 24 hrs. after shot _____

Gas _____ Cu. Ft.

Dry Hole _____

Abandoned _____

Date

FEB 15 1950 19

J. E. TYRA Scout