


Section 22 Township 12 Range 16W

Well No. #2 Ginther (B)-1000

Company Cities Service Oil

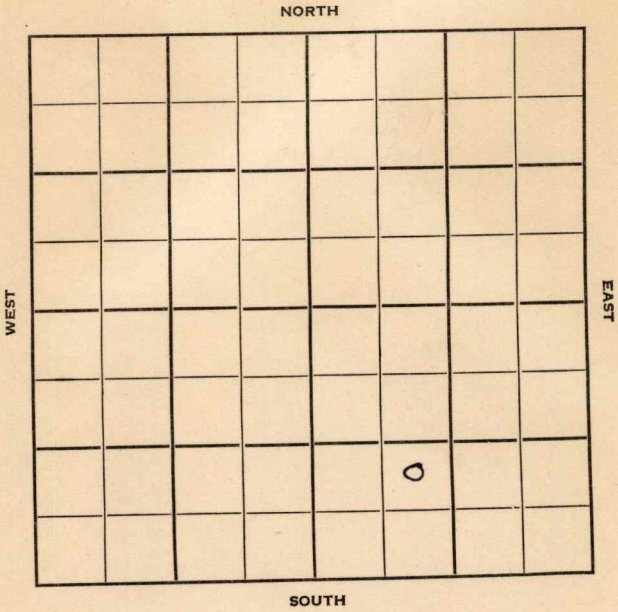

Ellis

Sec. 22 Twp. 12 R. **KANSAS**

Well No. #2 Ginther (B)-1000 Farm

Cities Service Oil Company

Holm - Contr. Contractor


Ft. from N. Line

1020' Ft. from S. Line

Ft. from E. Line

990' Ft. from W. Line

NE SW SE

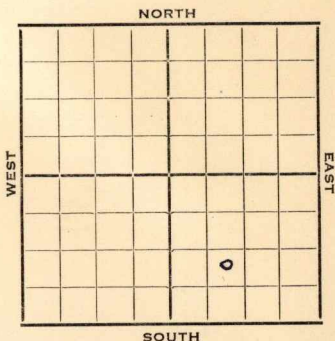

1952 Elev. 1941' REPORT

2/13 Spud 2-7-52  
8" @ 253  
Drlg. 2255'

2/20 **Topeka 2853' Heeb 3105' Dodge 3127  
Lans. 3154'**  
DST 3180-85, 1/2 hr, 75' MCO,  
850# BHP.  
DST 3216-40, 1/2 hr, 15' GCM, 300'  
MCO, 60' oil, 600#  
**Arb. 3418' TD 3419' 5" @ 3419'**

3/5 Spud 2-7-52  
Oil Well TD 3427  
8" @ 253 **Top 2853 Heeb. 3105  
Do ge 3127 Lans. 3154**  
DST 3180-85 opn 1/2 hr. Rec. 75' mco  
DST 3216-40 opn 1/2 hr Rec 15' gcm  
300' mco 60' oil  
**Arb. 3418 TD 3419 5" @ 3419**  
TD 3427 Comp. 217 bopd

**COMPLETED**



