

Ellis


O. W. P. B.

KANSAS

Section 22 Township 12 Range 16W

Well No. #3 Ginther "A"

Company Cities Service Oil

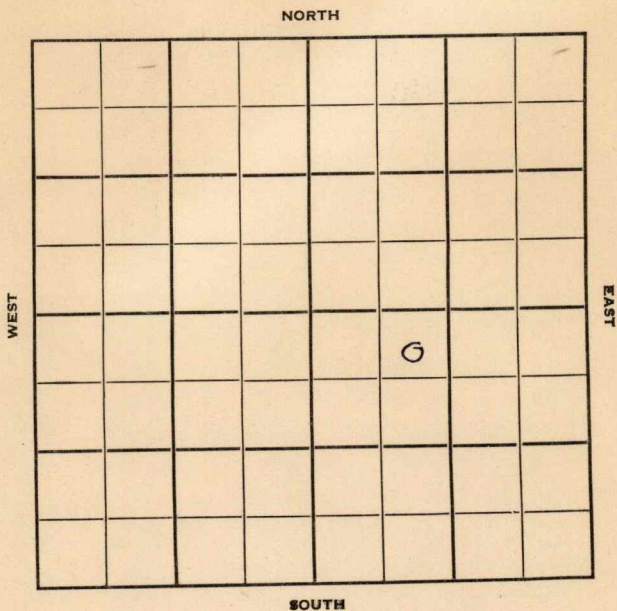

Ellis

O. W. P. B.

KANSAS ✓

Sec. 22 Twp. 12 R. 16W

Well No. #3 Ginther A Farm

Cities Service Oil Company

Holm Contractor


330 Ft. from N. Line

Ft. from S. Line

Ft. from E. Line

990 Ft. from W. Line

NE NW SE

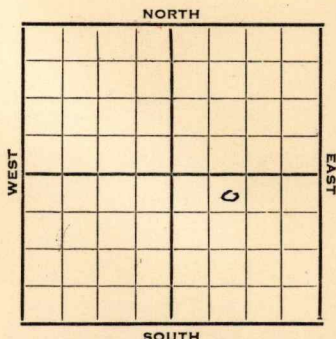

1952 Elev. 1956' REPORT

5/7 Spud 5-3-52
8" @ 245'
Drlg. 1334'

5/14 Tarkio 2607' Topeka 2873' Heeb 3126'
Dodge 3145' Lans. 3175'

DST 3202-08, 1 hr, 30' M 830#

DST 3240-63', 1 hr, 20' M 515#

DST 3265-74, 1 hr, 30' M 770#

Drlg. 3280'

5/21 Arb 3444 RTD 3448 5" @ 3445

5/28 RUST

6/11 DD 3461 1000 A

6/18 P/3 BO plus 5½ BWPD PB 3453'
2500 A DD 3464' 145' oil & 70' wtr
8 hrs.

6/25 Spud 5-3-52 D&A TD 3464'

Tar. 2607

Top. 2873

Heeb. 3126

Dodge 3145

Lans. 3175

DST 3202-08 open 1 hr. rec. 30' mud

DST 3240-63 open 1 hr. rec. 20' mud

DST 3265-74 open 1 hr. rec. 30' mud

Arb. 3444 TD 3448 5" @ 3445

DD 3461 1000 A P/3 bo 5½ bwph

PB 3453 2500 A DD 3464 FU 145' oil
70' wtr. D&A

ABANDONED

OVER

1954

O. W. P. B.

9/15

Oil Well

TD 3461'

Lans 3175', Arb 3444'

5" @ 3445'

OTD 3461'

D & A

PB 3412'

14/ 3353-66 39/ 3353-66 3 BO

/ 11 BW 11 hrs. Sqz & CO 3381

17/ 3345-49 21/ 3350-60 51/

3323-36 2500 A

P 9 BO / 48 BWPD

FIRST REPORT

COMPLETED

County **Ellis** State **Kansas**
 Sec. **22** (Blk.) **12** (Sur.) **16W** Map No.
 Operator **Cities Service Oil**
 Well No. **3** Farm **Cinther**
 Elev. Location **NE NW SE**



330 Ft. From **N** Line **SE**
990 Ft. From **W** Line Quarter
 1st. Report **MAY 7 1952**

Completion

Remarks

Halm - Contr.

Spudding Date **5-3-52**

Drig. Data

8" @ 245 Drig. 1334

J. G. McGEHEE

County Ellis State Kansas
 Sec. 22 (Blk. 12) (Sur. 16W) Map No.
 Operator Cities Service
 Well No. 3 Farm Ginther
 Elev. 1956 Location NE NW SE



330 Ft. From N Line SE
990 Ft. From W Line Quarter

1st. Report

Completion JUN 25 1952

Remarks

Holm Drlg. - Contr.

Spudding Date 5-3-52

Drlg. Data D & A TD 3464

8" @ 245 Tarkio 2607 Top. 2873

Heeb. 3126 Dodge 3145 Lans. 3175

DST 3202-08 open 1 hr. Rec. 30' mud

DST 3240-63 open 1 hr. Rec. 20' mud

DST 3265-74 open 1 hr. Rec. 30' mud

Arb. 3444 TD 3448 5" @ 3445 DD 3461

1000 A P/ 3 bo 5 $\frac{1}{2}$ bwph PB 3453

2500 A DD 3464 FU 145' oil 70' water

D & A

J. G. McGEHEE

FABEN GILSTRAP