


Section 11 Township 12 Range 16-W

Well No. #1 Oswald

Company J. C. Shaffer

NORTH Blue Hill Pool

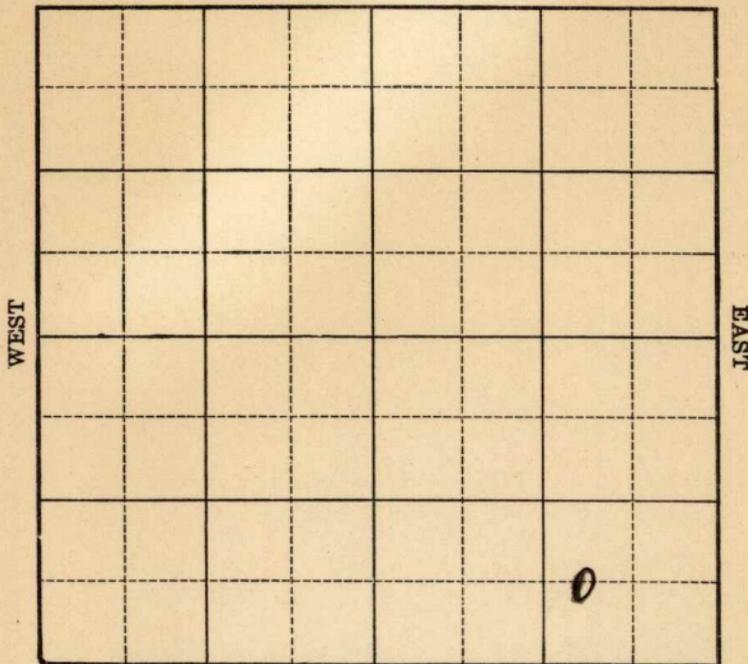

SOUTH

1940
5/22

Lans. 3075'
6" - 3225'
T.D. 3225'
88 shots 2993-2803'
9500 acid.
Potential 859 bbls., pump.

COMPLETED

Map No. 71 Sec. 11 Twp. 12 R. 16W

Well No. 1 Oswald

J. C. Shaffer

Company

Contractor

FIRST REPORT

C W L SE SE

_____ Ft. from N. Line

660 Ft. from S. Line

990 Ft. from E. Line

_____ Ft. from W. Line

BLUE HILL POOL

SECTION PLAT

			●

Location _____

Rig up _____

Drilling and Remarks:

Cellar & Matl.

RECORD

Cased _____ in., _____ ft.

Sand _____

Gas _____

Oil _____

Total Depth _____

PRODUCTION

1st 24 hrs. Nat. _____

1st 24 hrs. after shot _____

Gas _____ Cu. Ft.

Dry Hole _____

Abandoned _____

Date

APR 10 1940 19

S. J. LEWIS

Scout

Map No. 71 Sec. 11 Twp. 12 R. 16W

Well No. 1 Oswald

J. C. Shaffer Company

Contractor

COMPLETED

C W L SE SE

 Ft. from N. Line

660 Ft. from S. Line

990 Ft. from E. Line

 Ft. from W. Line

BLUE HILL POOL

SECTION PLAT

			0

Location

Rig up

Drilling and Remarks:


RECORD

Cased in., ft.

Sand

Gas

Oil

Total Depth 3225

PRODUCTION

1st 24 hrs. Nat.

1st 24 hrs. after shot

Gas Cu. Ft.

Dry Hole

Abandoned

Date

MAY 22 1940 19

S. J. LEWIS Scout