



Ellis

Map No. **KANSAS** Sec. 34 Twp. 13 R. 16<sup>w</sup>

Well No. 1 P. Mermis Farm


Ashby Company

330 Ft. from N. Line

\_\_\_\_\_ Ft. from S. Line

\_\_\_\_\_ Ft. from E. Line

330 Ft. from W. Line

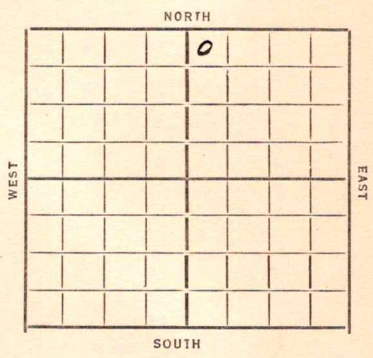

Date  
1934

REPORT

|              |                    |                    |                |
|--------------|--------------------|--------------------|----------------|
| <u>6/27</u>  | <u>Location</u>    |                    |                |
| <u>7/5</u>   | <u>Rig up r 5D</u> |                    |                |
| <u>7/12</u>  | <u>7/19</u>        | <u>7/26</u>        | <u>8/2</u>     |
| <u>8/9</u>   | <u>8/16</u>        | <u>8/23</u>        |                |
| <u>8/30</u>  | <u>15" 383</u>     | <u>dlg 755</u>     |                |
| <u>9/6</u>   | <u>dlg 1435</u>    | <u>Anhydrite</u>   | <u>1062</u>    |
| <u>9/13</u>  | <u>" 2225</u>      | <u>10" 1058</u>    |                |
| <u>9/20</u>  | <u>" 2645</u>      | <u>8" 2575</u>     |                |
| <u>9/27</u>  | <u>" 3010</u>      | <u>8" 2772</u>     |                |
| <u>10/4</u>  | <u>" 3345</u>      | <u>cewell 3197</u> | <u>6" 3248</u> |
| <u>10/11</u> | <u>No logs</u>     |                    |                |
| <u>10/17</u> | <u>cewell 3197</u> | <u>TD 3504</u>     |                |
|              | <u>HFW 3490</u>    | <u>DTA</u>         |                |

**ABANDONED**

KANSAS

Map No. 71 Sec. 34 Twp. 13 R. 16<sup>W</sup>

Well No. 1-P. Mermis

Ashby

Company

Contractor

**FIRST REPORTS**

**SECTION PLAT**

|  |  |   |  |
|--|--|---|--|
|  |  | 0 |  |
|  |  |   |  |
|  |  |   |  |
|  |  |   |  |

330 Ft. from N. Line

\_\_\_\_\_ Ft. from S. Line

\_\_\_\_\_ Ft. from E. Line

330 Ft. from W. Line

Location ✓

Rig up \_\_\_\_\_

Drilling and Remarks:



**RECORD**

Cased \_\_\_\_\_ in., \_\_\_\_\_ ft.

Sand \_\_\_\_\_

Gas \_\_\_\_\_

Oil \_\_\_\_\_

Total Depth \_\_\_\_\_

**PRODUCTION**

1st 24 hrs. Nat. \_\_\_\_\_

1st 24 hrs. after shot \_\_\_\_\_

Gas \_\_\_\_\_ Cu. Ft.

Dry Hole \_\_\_\_\_

Abandoned \_\_\_\_\_

Date

6-27-34 19

CORVAL MANNSCHECK

Scout

Map No. 71 Sec. 34 Twp. 13 R. 16W

Well No. 1-P. Mennis

Ashby

Company

Contractor

SECTION PLAT

**ABANDONED**

|  |  |   |  |
|--|--|---|--|
|  |  | 0 |  |
|  |  |   |  |
|  |  |   |  |
|  |  |   |  |

330 Ft. from N. Line

\_\_\_\_\_ Ft. from S. Line

\_\_\_\_\_ Ft. from E. Line

330 Ft. from W. Line

Location \_\_\_\_\_

RECORD

Cased \_\_\_\_\_ in., \_\_\_\_\_ ft.

Sand Orwald 3197

Gas \_\_\_\_\_

Oil \_\_\_\_\_

Total Depth 3504

Rig up \_\_\_\_\_

Drilling and Remarks:

H. F. W. 3490

PRODUCTION

1st 24 hrs. Nat. \_\_\_\_\_

1st 24 hrs. after shot \_\_\_\_\_

Gas \_\_\_\_\_ Cu. Ft.

Dry Hole \_\_\_\_\_

Abandoned \_\_\_\_\_

Date

**ORVAL MANNSCHRECK**

10-17-34 19

Scout