


Section 22 Township 12 Range 16WWell No. #2 GintherCompany Louis M. Mai

NORTH

WEST

EAST

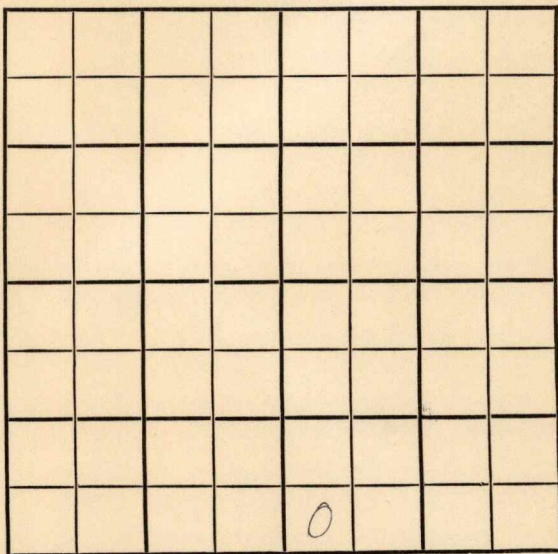

SOUTH

County Ellis Elev. _____
 Sec. 22 Twp. 12 Rge. 16W
 Company Louis M. Mai
 Farm Name Ginther No. 2

TOPS	DEPTH	LOG	DATUM	Loc. in Sec.
Anh.				SW SE SE
TP.				
H.				
Tr.				
Dg.				
Bl.				
L.				Geol.
K.C.				Contr.
B.K.C.				Co. Tools
Ce.				Pool
C.				Emmeran NE
M.				
M.				
K.				
Mz.				
Me.				
V.				
S.				
S.				
A.				
R.				
Pe.				
G.				
TD.				

FIRST REPORT

NOV 7 '56

Date Comm. spd. 11-1-56
8" @ 1081 w/525, Drlg. 2125

NOV 5 1956

R.G.

County Ellis Elev. 1928 RB
 Sec. 22 Twp. 12 Rge. 16W
 Company Louis M. Mai
 Farm Name Ginther No. 2

TOPS	DEPTH	LOG	DATUM	Loc. in Sec.
Anh.	1073			SW SE SE
TP.	2838			
H.	3090			
Tr.	3111			
Dg.				
Bl.				
L.	3140			Geol. <u>Nixon</u>
K.C.				Contr.
B.K.C.				Co. Tools
Ce.				Pool
C.				Emmeran NE
M.				
M.				
K.				
Mz.				
Mo.				
V.				
S.				
S.				
A	3407			
R.				
Pe.				
G.				
TD	3410			

Date Comm. spd. 11-1-56

8" @ 1081 w/525, Drlg. 2125

NOV 13 '56

Anhy 1073 TP 2838 H6 3090 Tr 3111

Lsg 3140 DST 3164-76 up the sec

2' Md BHP 655/20" DST 3236-40

the sec 13' Md BHP 280/ Arb 3407

RTD 3410 no Log 5 1/2 @ 3408 1/2 /125

WOCT. NOV 21 '56 X CO 3410 Notst 1/2 \$

5 Goph + Acid wtr 3 hrs 2200

Acid \$ 9 Goph + Acid wtr Tstg

NOV 26 '56

NOV 26 '56

X

PB 3400 24/3388-92 no tst nat.
 N B 6 Goph + 25 Gwph 10 hrs
 PB 3270 24/3232-36 no tst nat.
 N B 8 BFph App. 70% wts
 no time PB 3210 24/3166-70 N
 DEC 6 '58 \$ 7 BFph CO 3270
 SQD. CO 3238 24/3232-36
 N \$ Ld. DEC 12 '58 FU 380' Fluid
 12 hrs (25' oil) Tried to PB
 3184 Plug Leaked. Trying to
 SQ 3232-26 DEC 19 '58 CO Re SQ
 3166-70 CO Re PF 24/3166-70
 N \$ 12 BFph USSO PB
 3145 20/3111-16 N \$ 2
 BFph 95% wts PB 2900
 16/2867-71 \$ 4 1/4 BWph

Temp Add.

22-12-16

sw se se