
FORM 51 25M 3-49 PETROL

Barton KANSAS

Section 3 Township 17 Range 12W

Well No. #1 Stumps

Company Barnsdall

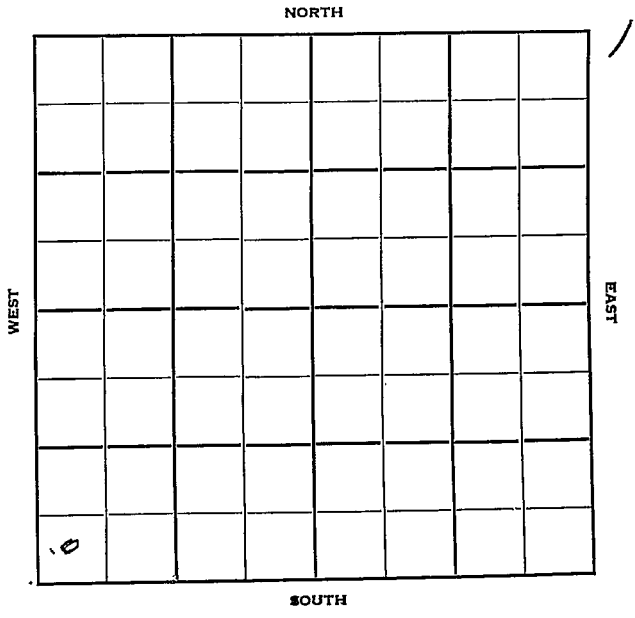

FORM 252-B
10M 9-49 PETROL

Barton KANSAS ✓
Sec. 3 Twp. 17 R. 12W

Well No. #1 - Stumps Farm

Barnsdall Company

Duke & Wood Contractor


____ Ft. from N. Line

430' Ft. from S. Line

____ Ft. from E. Line

330' Ft. from W. Line

SW SW SW

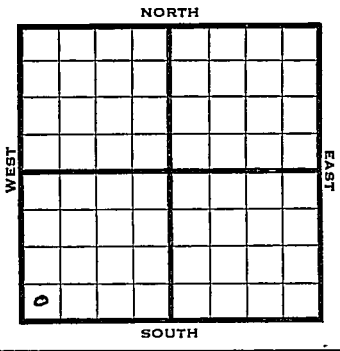

1950	Elev. 1848' REPORT
4/26	RUR
6/7	8" @ 180' Arb 3308' 5" @ 3308' Perf 12/3310 -13 P 41 BOPD 83% wtr.
	COMPLETED

Form 26 200 Bks. 11-49 Petrol

Kansas

Map No. _____ Sec. 3 Twp. 17 R. 12W

Well No. 1 Stumps

Barnsdall Company

Duke & Wood Contractor

SW S W SW

_____ Ft. from N. Line

430 Ft. from S. Line

_____ Ft. from E. Line

330 Ft. from W. Line

Barton County

SECTION PLAT



Location _____

Rig up _____

Drilling and Remarks:

R U R

RECORD

Cased _____ in., _____ ft.

Sand _____

Gas _____

Oil _____

Total Depth _____

PRODUCTION

1st 24 hrs. Nat. _____

1st 24 hrs. after shot _____

Gas _____ Cu. Ft.

Dry Hole _____

Abandoned _____

Date

APR 2 6 1950 19

J. E. TYRA Scout

Form 26 200 Bks. 11-49 Petrol

Kansas

Map No. _____ Sec. 3 Twp. 17 R. 12W

Well No. 1 Stumps


Barnsdall Oil
Company

Contractor

SW SW SW

El. 1848

SECTION PLAT

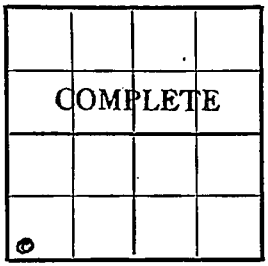

_____ Ft. from N. Line

430 Ft. from S. Line

_____ Ft. from E. Line

330 Ft. from W. Line

Barton

Location

Rig up

Drilling and Remarks:

8" @ 180
anh 3308
5" @ 3308
pay 12/3310-13
P 41 BOPD
83% nitr.

RECORD

Cased _____ in., _____ ft.

Sand

Gas

Oil

Total Depth

PRODUCTION

1st 24 hrs. Nat.

1st 24 hrs. after shot

Gas _____ Cu. Ft.

Dry Hole

Abandoned

Date

JUN 7 1950 19

J. E. TYR[illegible] Scout