

KANSAS

Ellis


FORM 51 5M BR1X

Section 1 Township 13 Range 17W

Well No. #1, Braun

Company Tom Allan et al.

16

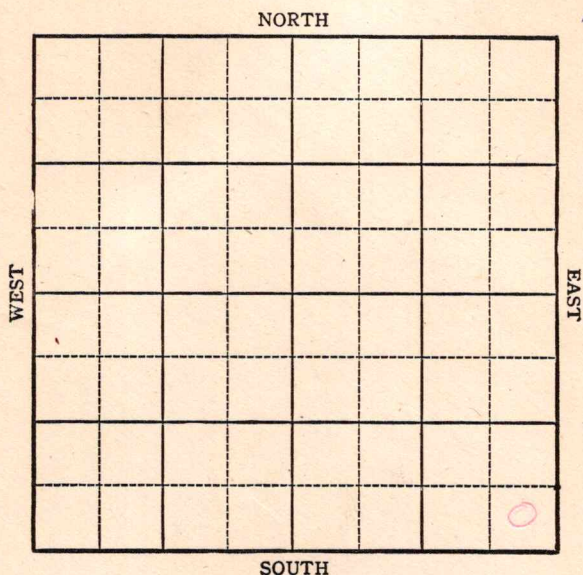

Ellis

Sec. 1 Twp. 13 R. 17W

Well No. #1 Braun Farm

Tom Allan et al. Company


Sugar Loaf

 Ft. from N. Line

330 Ft. from S. Line

330 Ft. from E. Line

 Ft. from W. Line

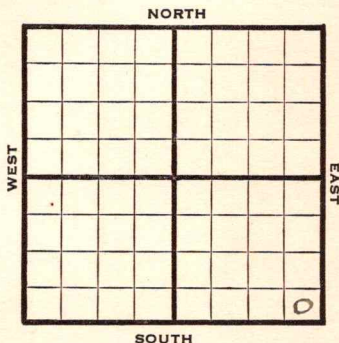

1944

R E P O R T

5/24 8" @ 111
Drlg. @ 1050'

5/31 **Anhy. 1172**
Drlg. 2458'

6/1 **Lans 3264**
Simp. 3534
Arb. 3547
SSO 3588-93 Drlg.

6/14 **Re Arb 3547**
Arb. 3570
TD 3609


ABANDONED

KANSASPool Name Sugar LoafMap No. 71 Sec. 1 Twp. 13 R. 17WWell No. 1 BraunTom Allan et al.

Company

FIRST REPORT

Contractor

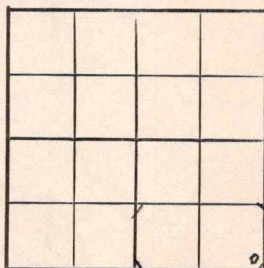SE/C**SECTION PLAT** Ft. from N. Line330 Ft. from S. Line330 Ft. from E. Line Ft. from W. LineEllis CountyLocation Rig up

Drilling and Remarks:

8" - 1111050**RECORD**Cased in., ft.Sand Gas Oil Total Depth **PRODUCTION**1st 24 hrs. Nat. 1st 24 hrs. after shot Gas Cu. Ft.Dry Hole Abandoned

Date

MAY 24 194419S. J. LEWISScout

Sugar Loaf

Map No. 11 Sec. 1 Twp. 13 R. 17W

Well No. 1 Braun

Tom Allan et al. _____ Company

ABANDONED

Contractor

SE/C


SECTION PLAT

_____ Ft. from N. Line

330 Ft. from S. Line

330 Ft. from E. Line

Ft. from W. Line

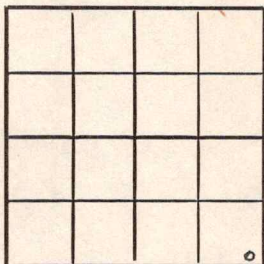

Ellis County

RECORD

Location _____

Cased _____ in. _____ ft.

Rig up_____

Sand

Drilling and Remarks:

Gas _____

Oil _____

Total Depth 3649

PRODUCTION

1st 24 hrs. Nat. _____

1st 24 hrs. after shot_____

Gas _____ Cu. Ft.

Dry Hole_____

Abandoned

Date _____

JUN 14 1944 19

S. J. LEWIS Scout