


Section 22 Township 12 Range 16W

Well No. #4 Ginther "A"

Company Cities Service

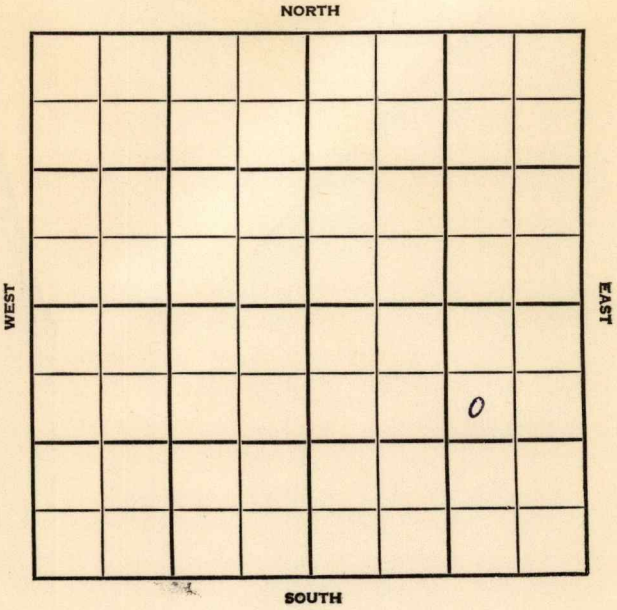

Ellis

KANSAS

SEC.	TWP.	R.
22	12	16 W ✓

WELL NO.

4 Ginther "A"

FARM

COMPANY

Cities Service

CONTRACTOR

NE Emmeram Pool


990 Ft. from N. Line

Ft. from S. Line

990 Ft. from E. Line

Ft. from W. Line

SW NE SE

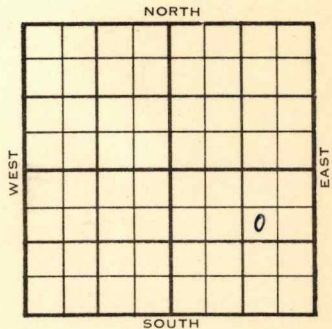

	ELEVATION	REPORT
1954	1935'	
5/19	Location	
6/23	Spud 5-20-54 - Oil Well	
	TD 3519'	
	8" @ 240'	
	Dodge 3123', Lans 3153'	
	DST 3179-88', opn 1 hr., rec. 60'	
	ho & gcm, 124' o & gcm & wtr., 685#	
	DST 3199-3237', opn 1 hr., rec. 8' mud	
	180#	
	DST 3247-75', opn 1 hr., rec. 5' mud,	
	0#	
	DST 3313-39', opn 1/2 hrs., rec. 2200'	
	gas, 210' gco, 1075#	
	DST 3357-88', opn 1 hr., rec. 50' sw,	
	920#	
	B KC 3390', Cong 3422'	
	TD 3519'	
	5" @ 3519'	
	CO to 3410'	
	37/3331-40, 36/3310-19, 1000A	
	Comp. 92 bopd 26 bw	

COMPLETED

County **Ellis** State **Kansas**

Sec. **22** (Blk. Twp.) **12** (Sur. Rge.) **16W** Map No.

Operator **Cities Service**

Well No. 4 Farm Ginther "A"

Elev.	Location	SW	NE	SE
-------	----------	----	----	----

FIRST REPORT

County Ellis State KansasSec. 22 (Blk.
Twp.) 12 (Sur.
Rge.) 16W Map No.Operator Cities ServiceWell No. 4 Farm Ginther "A"Elev. 1935 Location SW NE SE990 Ft. From N Line SE990 Ft. From E Line Quarter1st. ReportCompletion JUN 23 1954Remarks NE Emmeram PoolSpudding Date 5-20-54Drlg. Data Oil well TD 35198" @ 240 Dodge 3123 Lans. 3153DST 3179-88 open 1 hr. Rec. 60' ho &gcm 124' o & gcm & wtr. 685#DST 3199-3237 open 1 hr. Rec. 8' mud180# DST 3247-75 open 1 hr. Rec. 5' mud0# DST 3313-39 open $\frac{1}{2}$ hr. Rec. 2200'gas 210' gco 1075# DST 3357-88 open1 hr. Rec. 50' sw 920# B KC 3390Cong. 3422 TD 3519 5" @ 3519CO to 3410 37/ 3331-40 36/ 3310-191000 A Comp. 92 bopd 26 bw

J. G. McGEHEE