


Section 3 Township 17 Range 12-W

Well Number 1 Stumps


Company C. H. Weaver et al

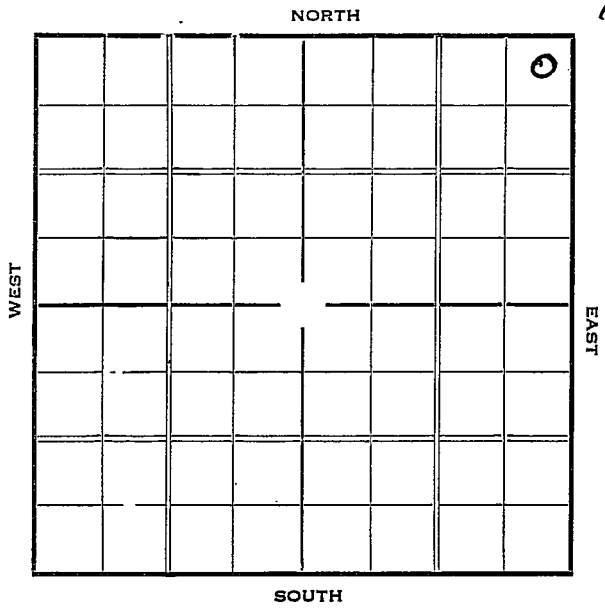

Sec. 3 Twp. 17 R. 12-W

Well No. #1 Stumps Farm
C. H. Weaver et al Company

330 Ft. from N. Line
 _____ Ft. from S. Line
330 Ft. from E. Line
 _____ Ft. from W. Line

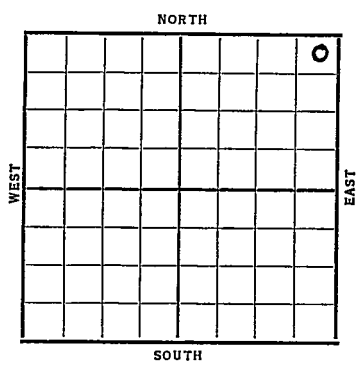

Special

| Date | Elev. 1883 | REPORT |
|------|--------------------------------------|--------|
| 1937 | | |
| 3/24 | R O G | |
| 4/2 | Rig. | |
| 4/8 | Spud | |
| 4/16 | 15" @ 348'. 12" @ 535'. | |
| | T.D. 750' SD | |
| 4/23 | 12" @ 749'. Drlg. 1190'. | |
| 4/30 | Drlg. 2075'. | |
| 5/7 | 8" @ 2490'. Drlg. 2590'. | |
| 5/14 | Lansing 3090'. Drlg. 3180'. | |
| 5/19 | Sil. 3365'. | |
| | T.D. 3383'. | |
| | Small S. O. 3373-76'. | |
| | H.F.W. 3383'. | |
| | ABANDONED ABANDONED ABANDONED | |

KANSAS *Barton*

Map No. 53 Sec. 3 Twp. 17 R. 12W

Well No. 1 Stumps

C. H. Weaver et al Company

Contractor

Special

SECTION PLAT

330 Ft. from N. Line

_____ Ft. from S. Line

330 Ft. from E. Line

_____ Ft. from W. Line

| | | | |
|--|--|--|---|
| | | | 0 |
| | | | |
| | | | |
| | | | |

FIRST REPORT

Location _____

Rig up _____

Drilling and Remarks:

ROG

RECORD

Cased _____ in., _____ ft.

Sand _____

Gas _____

Oil _____

Total Depth _____

PRODUCTION

1st 24 hrs. Nat. _____

1st 24 hrs. after shot _____

Gas _____ Cu. Ft.

Dry Hole _____

Abandoned _____

Date

1912 19

S. J. LEWIS Scout

Barton KANSASMap No. 55 Sec. 3 Twp. 17 R. 12^WWell No. 1 - StumpsC. H. Weaver Company

Contractor

COMPLETED

SECTION PLAT

| | | | |
|--|--|--|---|
| | | | 0 |
| | | | |
| | | | |
| | | | |

330 Ft. from N. Line

_____ Ft. from S. Line

330 Ft. from E. Line

_____ Ft. from W. Line

Location _____

Rig up _____

Drilling and Remarks:

*Small S.O.
3373-76**H.F.W. 3383**D & A*

RECORD

Cased _____ in., _____ ft.

Sand 511 3365

Gas _____

Oil _____

Total Depth 3383

PRODUCTION

1st 24 hrs. Nat. _____

1st 24 hrs. after shot _____

Gas _____ Cu. Ft.

Dry Hole _____

Abandoned _____

Date

MAY 19 1937 19

H. D. Hatfield Scout