

Barton

KANSAS

SECTION 4 TOWNSHIP 17 RANGE 12 W

WELL NO. #1 Lang

COMPANY Bennett & Roberts

NORTH

							0

WEST

EAST

SOUTH

Barton

KANSAS

SEC.

TWP.

R.

4

17

12W

WELL NO.

#1 Lang

FARM

COMPANY

Bennett & Roberts

CONTRACTOR

Co. Tools


Ft. from N. Line

Ft. from S. Line

Ft. from E. Line

Ft. from W. Line

SE NE NE

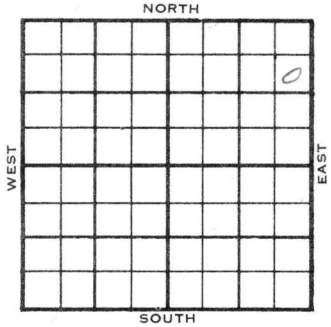

1956

ELEVATION

REPORT

1-5

Comm. 1-2-56
8" @ 225/175
Drlg. 1419

County Barton Elev. _____
 Sec. 4 Twp. 17 Rge. 12W
 Company Bennett & Roberts
 Farm Name Lang No. 1

TOPS	DEPTH	LOG	DATUM	Loc. in Sec.
Anh.				SE NE NE
Tp.				
H.				
Tr.				
Dg.				
B.L.				
L.				Geol.
K.C.				Contr.
B.K.C.				Co. tools
Ce.				
C.				Pool
M.				
M.				
K.				
Mz.				
Me.				
V.				
S.				
S.				
A				
R.				
Pe.				
G.				
T.D.				

FIRST REPORT

JAN 5 '56

Date Comm. 1-2-56
8" @ 225/175 drlg. 1419

13

187507

County Barton Elev. 1878 RB
 Sec. 4 Twp. 17 Rge. 12W
 Company Bennett & Roberts
 Farm Name Long No. 1

TOPS	DEPTH	LOG	DATUM	Loc. in Sec.
Asb.				SE NE NE
Tp.				
H.	2969			
Tr.	2986			
Bp.	2998			
Bl.	3060		1182	
L.	3080		1202	
K.C.				Coal.
BKC.				Cont.
Co.				Co. tools
C.	3320		1442	
M.				Pool adia
M.				
K.				
M.				
M.				
V.				
S.				
S.				
A.	✓ 3329		1451	
R.				
PC.				COMPLETE
G.				
20	3331			

Date Comm. 1-2-56 FEB 29 1956

8" @ 225/175 drlg. 1419 JAN 11 '56

DST 3070-3104 1hr run 14' DMD
no BHP @ 3141 JAN 18 '56 DST 3108-41 1hr run 20' 50CM BHP 0
120 DST 3211-32 1hr run 30'

ACM BHP 240 5 1/2 3330 JAN 25 '56

CO DD 3332 TV 8 45 Bapd Nat

Pop FEB 1 '56 ✓ FEB 8 '56 ✓ FEB 15 '56 FEB 22 '56

✓

FEB 29 1956

P. 45 B0 + Tr. wh
24 hr.

R. G.

MAR 8 1956