KANSAS


FORM 51 5M 10-41 PETROL

Barton

Section 4 Township 17 Range 12-W

Well No. #1 Wondra

Company Nat Appleman & Co.

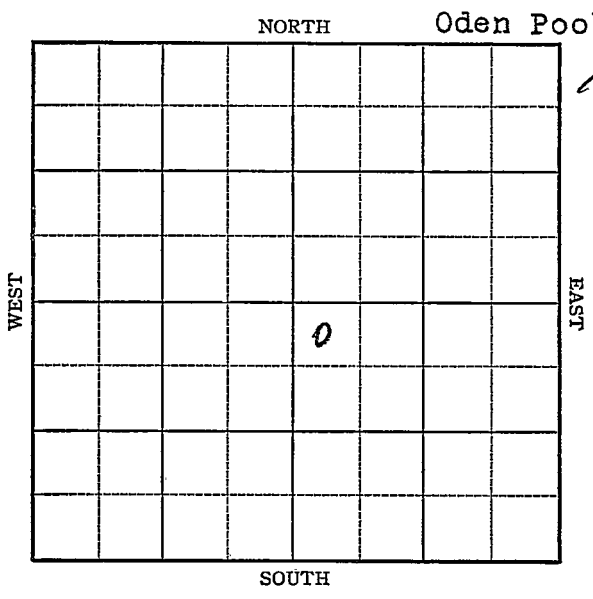

FORM 252-A
5M 10-41 PETROL

KANSAS Barton

Sec. 4 Twp. 17 R. 12 -W

Well No. #1 Wondra Farm

Nat Appleman & Co. Company


(Oden)

330 Ft. from N. Line

_____ Ft. from S. Line

330 Ft. from E. Line

_____ Ft. from W. Line

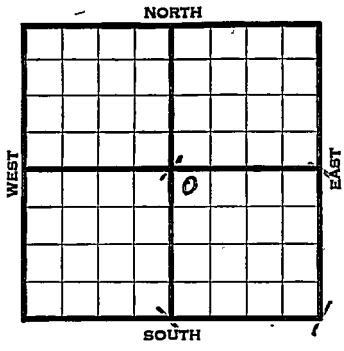

Elev 1889

1942	REPORT
1/21	Location
1/28	"
2/5	"
2/12	"
2/19	Cellar.
2/26	Rotary.
3/5	"
3/12	Drlg. 290'
3/19	15" - 375' Drlg. 560'
3/26	Anhy 765' 12" - 771' Drlg. 1000'
4/2	Wreford 1930' Neva 2110'
	Drlg. 2363'
4/8	Topeka ~~2785'~~ 2695 8" - 2265'
	Fsg. 2925'
4/15	Topeka 2695' (Corrected) Lans. 3118'
	5" - 3107' Drlg. 3177'

OVER

1942
4/22 Arb. 3370'
T.D. 3412'
H.F.W.

ABANDONED

Form 26 200 Bks. 5-41 McW.

Barton KANSAS

Map No. 57 Sec. 4 Twp. 17 R. 12W

Well No. 1 Wondra

Nat Appleman & Co. Company

FIRST REPORT Contractor

NW SE


330 Ft. from N. Line

_____ Ft. from S. Line

330 Ft. from E. Line

_____ Ft. from W. Line

SECTION PLAT

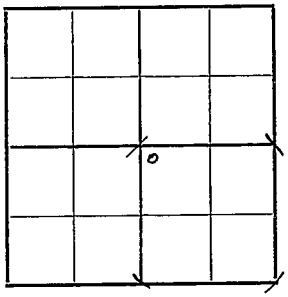

ODEN POOL

Location XX

Rig. up

Drilling and Remarks:

RECORD

Cased _____ in., _____ ft.

Sand

Gas

Oil

Total Depth

PRODUCTION

1st 24 hrs. Nat.

1st 24 hrs. after shot

Gas _____ Cu. Ft.

Dry Hole

Abandoned

Date

JAN 21 1942 19 S. J. LEWIS Scout

Form 26 200 Bks. 5-41 McW. Barton KANSAS

Map No. 55 Sec. 4 Twp. 17 R. 12W

Well No. 1 Wondra

Nate Appleman & Co, Company

ABANDONED Contractor

NW SE


330 Ft. from N. Line

____ Ft. from S. Line

330 Ft. from E. Line

____ Ft. from W. Line

SECTION PLAT

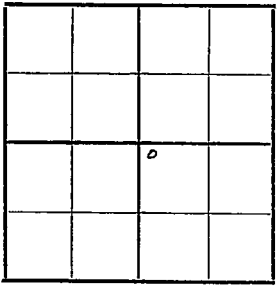

ODEN POOL

Location ____

Rig up ____

Drilling and Remarks:

Cut f. 3370

HFW.

RECORD

Cased ____ in., ____ ft.

Sand ____

Gas ____

Oil ____

Total Depth 3412

PRODUCTION

1st 24 hrs. Nat. ____

1st 24 hrs. after shot ____

Gas ____ Cu. Ft.

Dry Hole ____

Abandoned ____

Date

APR 22 1942 19 S. J. LEWIS Scout