


Section 23 Township 12 Range 16-W

Well No. #1 Smith "A"

Company Tom Palmer etal
Blue Hill Pool

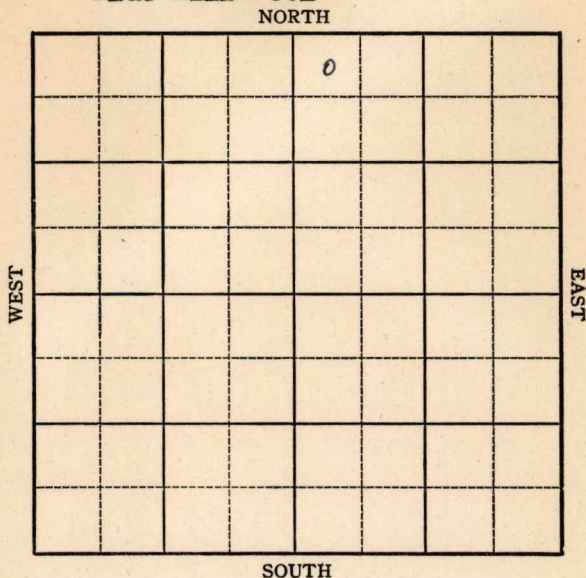

Ellis KANSAS ✓

Sec. 23 Twp. 12 R. 16W

Well No. #1 Smith "A" Farm

Tom Palmer et al Company

Blue Hill Pool (Braden, Contour)


330' Ft. from N. Line

 Ft. from S. Line

 Ft. from E. Line

330' Ft. from W. Line

NW NE

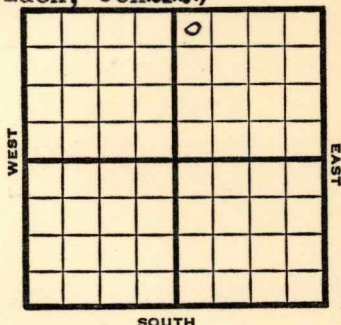

1949 Elev 1837' REPORT

11/16 8" @ 102'
Anhy 933'
Drlg. 2340'
11/23 TD 3370' in Cong.
Lansing 3061'
Cong 3338'
Aband.

ABANDONED

Kansas


Map No. _____ Sec. 23 Twp. 12 R. 16WWell No. 1 Smith "A"_____
Tom Palmer et al. _____ Company_____
Braden _____ Contractor

NW NE

FIRST REPORT
SECTION PLAT330 Ft. from N. Line

_____ Ft. from S. Line

_____ Ft. from E. Line

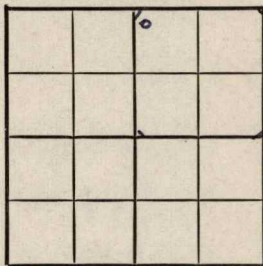330 Ft. from W. Line

Ellis County

Location _____

Rig up _____

Drilling and Remarks:

8" @ 102

Anhy 933

drlg. 2340

RECORD

Cased _____ in., _____ ft.

Sand _____

Gas _____

Oil _____

Total Depth _____

PRODUCTION

1st 24 hrs. Nat. _____

1st 24 hrs. after shot _____

Gas _____ Cu. Ft.

Dry Hole _____

Abandoned _____

Date

NOV 16 1949

19

S. J. LEWIS

Scout

Kansas

Map No. _____ Sec. 23 Twp. 12 R. 16WWell No. 1 Smith "A"

Tom Palmer et al.

Company

ABANDONED

Contractor

NW NE

E. 182
SECTION PLAT330 Ft. from N. Line

Ft. from S. Line

Ft. from E. Line

330 Ft. from W. Line

		0	

Ellis County

Location _____

Rig up _____

Drilling and Remarks:

*Lane 306/**Cong 335*

RECORD

Cased _____ in., _____ ft.

Sand _____

Gas _____

Oil _____

Total Depth 3370 in Cong

PRODUCTION

1st 24 hrs. Nat. _____

1st 24 hrs. after shot _____

Gas _____ Cu. Ft.

Dry Hole _____

Abandoned _____

Date

NOV 23 1949

19

S. J. LEWIS

Scout