


Section 24 ~~13~~ Township 12 Range 16W

Well No. #1 ~~#4~~ Dreiling

Company L. J. Dreiling

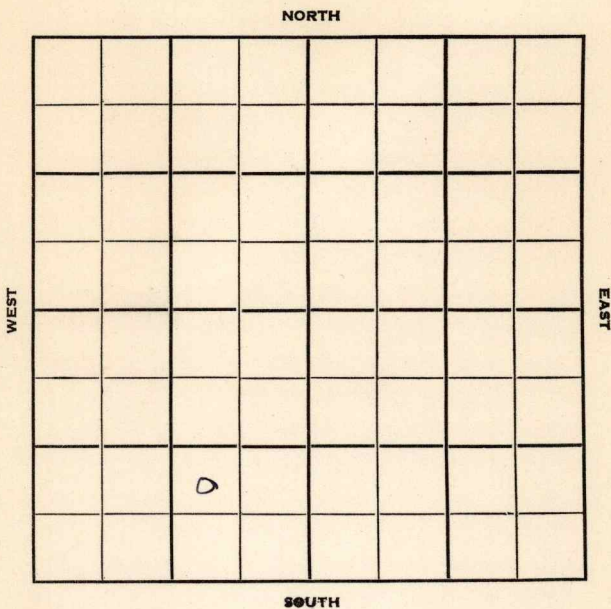

Ellis

KANSAS

Sec. 13-24 Twp. 12 R. 16W

Well No. #1
#4 Dreiling Farm

L. J. Dreiling Company

Glenn Nye Drilg. - C ontr. Contractor
Emmerman Pool


Ft. from N. Line

NORTH

990' Ft. from S. Line

990' Ft. from E. Line

Ft. from W. Line

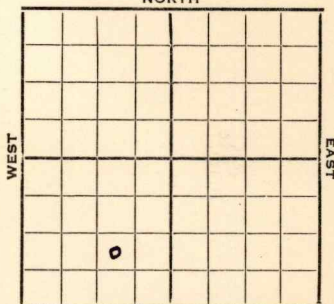

NW SE SW

SOUTH

1951 Elev. 1877' REPORT

12/12 MIRT

1952

1/16

Spud 12-11-51

D&A TD 3450

8" @ 71

Top. 2781

Heeb. 3058

Lans. 3109

Marm. 3338

Cong. 3391

Arb. 3424-50 TD

D&A

ABANDONED


Sec. 13 (Blk.) 12 (Sur.) 16W Map No.

Operator **L. J. Dreiling**

Well No. 4 Farm Dreiling

Elev.	Location	NW	SE	SW

990 Ft. From S Line SW

990 Ft. From **E** Line Quarter

1st. Report DEC 1 2 1951

Completion

Remarks

Glenn Nye Drlg. - Contr.

Spudding Date _____

Drig. Data Emmerman Pool

M I R T

J. E. TYRA

Kansas

Map No. _____ Sec. 24 Twp. 12 R. 16WWell No. 1 DreilingL. J. Dreiling Company

CORRECTION

Contractor

NW SE SW

SECTION PLAT

	b		

_____ Ft. from N. Line

990 Ft. from S. Line990 Ft. from E. Line

_____ Ft. from W. Line

Ellis County

RECORD

Location _____

Cased _____ in., _____ ft.

Rig up _____

Sand _____

Drilling and Remarks:

Gas _____

Oil _____

Reported

Total Depth _____

#4 Dreiling

PRODUCTION

13-12-16W

1st 24 hrs. Nat. _____

1st 24 hrs. after shot _____

Gas _____ Cu. Ft.

Dry Hole _____

Abandoned _____

Date

JAN 16 1952 19J. E. TYRA

Scout

U. E. TYRA