

Section 23 Township 12 Range 16 W

Well No. # 1 Sidey

Company Kewanee Oil

NORTH

WEST

EAST

0

SOUTH

Ellis

KANSAS ✓


Sec. 23 Twp. 12 R. 16W

Well No. #1 Sidey Farm

Kewanee Oil Company

Contractor

_____ Ft. from N. Line
330 Ft. from S. Line
_____ Ft. from E. Line
330 Ft. from W. Line

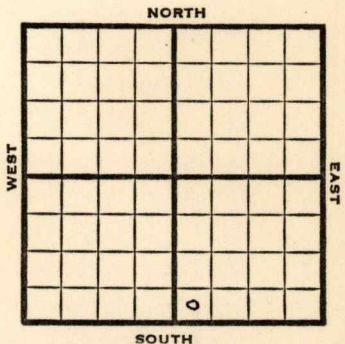

SW SW SE

1952

Elev. 1889' REPORT

8/13

Spud 8-7-52
8" @ 212'
Anhy 1035'
Drlg. 1654'

8/20

Heeb 3072' Dodge 3094' Lans. 3122'
Drlg. 3209'

8/27

Spud 8-7-52
D&A TD 3461'
8" @ 212'

Anhy 1035 Heeb. 3072
Dodge 3094 Lans. 3122

DST 3370-93 open $\frac{1}{2}$ hr. rec. 9' mud
980# **Cong. 3400 Arb. 3448**
TD 3461' D&A

ABANDONED

