


Section 2 Township 13S Range 17W

Well No. #1 Leikam

Company Nadel & Gussman

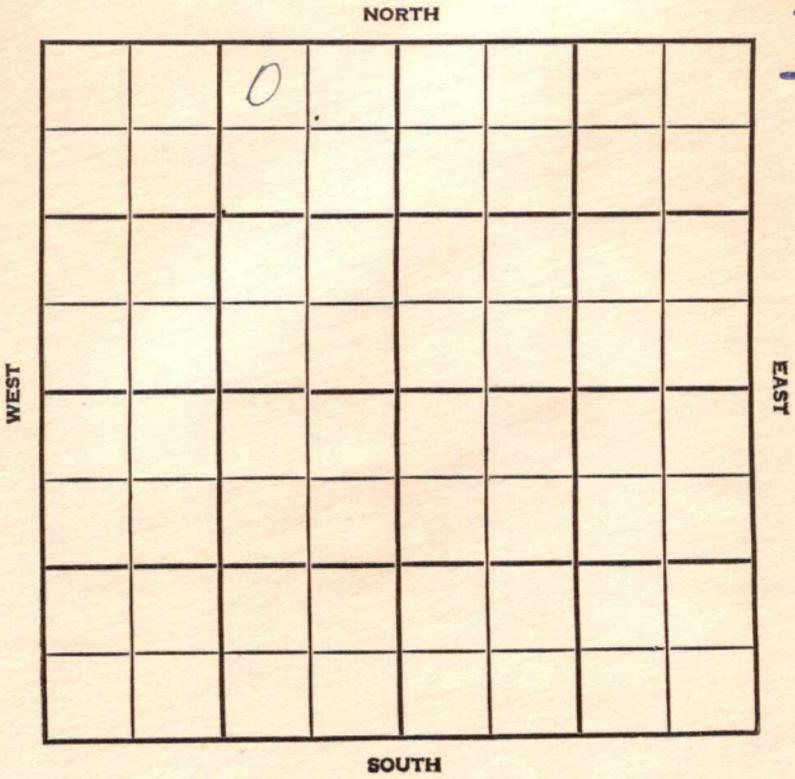

P100117

FORM 513 SUNRAY

County Ellis Elev. \_\_\_\_\_

Sec. 2 Twp. 13S Rge. 17W

Company Nadel & Guesman

Farm Name Leikam No. 1

TOPS	DEPTH	LOG	DATUM
Anh.			
Tp.			
H.			
Tr.			
Dg.			
Bl.			
L.			
K.C.			
B.K.C.			
Ce.			
C.			
M.			
M.			
K.			
Mz.			
Mq.			
V.			
S.			
S.			
A.			
R.			
Pe.			
G.			
T.D.			

Loc. in Sec. NW NE NW

DS- N<sup>1</sup>/<sub>2</sub> Nw<sup>1</sup>/<sub>4</sub>

Geol. \_\_\_\_\_

Contr. \_\_\_\_\_

Reserve

Pool

Wildcat

FIRST REPORT

OCT 3 56

Date Comm. WOBT

OCT 5 1956

R.G.

Co.

Lse.

No.

Sec.

T.

R.

County Ellis Elev. 2062  
 Sec. 2 Twp. 13S Rge. 17W  
 Company Nadel & Gresham  
 Farm Name Leikam No. 1

TOPS	DEPTH	LOG	DATUM	Loc. in Sec.
Anh.	1233			NW NE NW
Tp.				
H.	3276			DS - N-NW $\frac{1}{2}$
Tr.	3298			
Dg.				
Bl.				
L.	3324			
K.C.				Geol.
B.K.C.				Contr.
C.				Reserve
C. <u>cherty</u>	3586			
M.				
M.				Pool
K.				Wildcat
Mz.				
Me.				
V.				
S.				
S.				
A.	3596			
R.				
PC.				
G.				
TD.	3630			ABANDONED

OCT 17 '56

Date Comm. WOET OCT 10 '56 10-4-56 8578

200135 @ 25.34 OCT 17 '56

DST 3370-92 90" well 105' SW

BHP 1020 DST 3394-3421 30"

610' SW BHP 930

D&A