


Section 4 Township 17 Range 12W

Well No. #1 Lang "A"

Company Mallard Drlg. Company

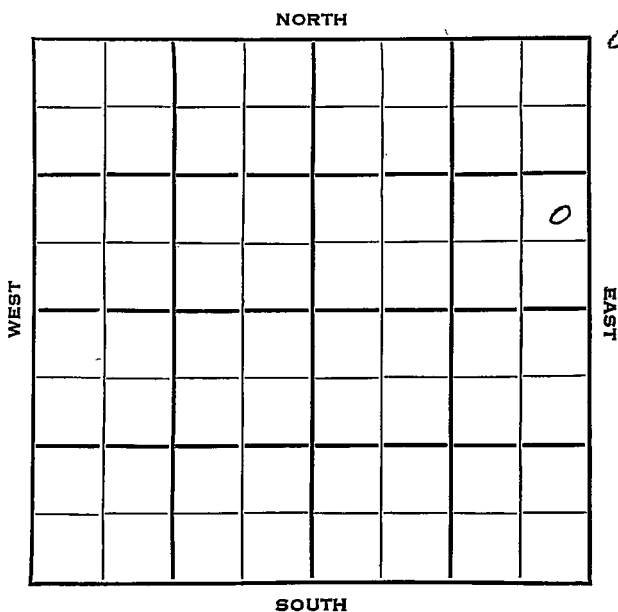

Sec. 4 Twp. 17 R. 12W

Well No. #1 Lang "A" Farm _____

Mallard Drlg. Company _____

Mallard Drlg. Contractor _____


_____ Ft. from N. Line

990 Ft. from S. Line

330 Ft. from E. Line

_____ Ft. from W. Line

NE SE NE

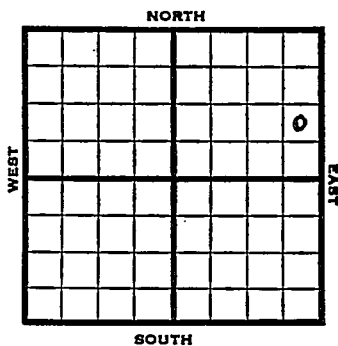

1953

Elev. 1854'

REPORT

3/25
4/2

Location
8" @ 255
Drlg. 2350'

4/9

Arb. 3309' RTD 3311 5" @ 3310

4/16

D_a 3315 TD
FU 1500' oil + trace 12 hrs., POP

4/22

Spud 3-26-53
Oil well TD 3315 8" @ 255 Arb. 3309'
TD 3311 5" @ 3310 DD 3315 FU 1500'
oil 12 hr.
Comp. 25 BOPD

COMPLETED

