

Barton


KANSAS

DX 78-1

Section 4 Township 17 Range 12W

Well No. #1 Wondra

Company Jim Chew

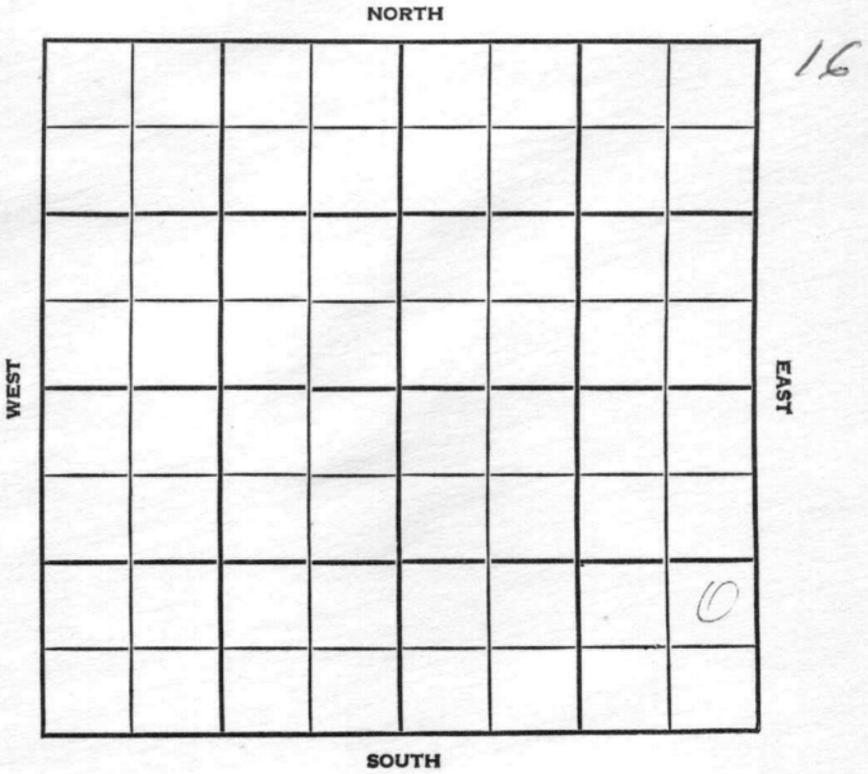

County Barton Elev. _____
 Sec. 4 Twp. 17 Rgs. 12W
 Company Jim Chew
 FarmName Wondra No. 1

TOPS	DEPTH	LOG	DATUM
Anh.			
TP.			
H.			
Tr.			
Dg.			
Bl.			
L.			
K.C.			
B.K.C.			
Ce.			
C.			
M.			
M.			
K.			
Mz.			
Me.			
V.			
S.			
S.			
A.			
R.			
Pe.			
G.			
T.D.			

Loc. in Sec. NE SE SE
 Geol. _____
 Contr. _____
 Peel Bros. Tools
 Pool _____
 Odin
 FIRST REPORT
 OCT 31 '55

Date Comm. spd. 10-28-56
8" @ 310 w/175, Drlg. 360

Co.
 Ls.
 No.
 Sec.
 T.
 R.

[Handwritten signature]
 NOV 5 1956

County Barton Elev. 1864
 Sec. 4 Twp. 17 Rgd. 12W
 Company Jim Chew
 Farm Name Wondra No. 1

Co.

TOPS	DEPTH	LOG	DATUM
Anh.			
Tr.			
H.	<u>2960</u>		
Tr.			
Dg.			
Bl.	<u>3052</u>		
L.	<u>3068</u>		
K.C.			
B.K.C.			
Ce.			
C.			
M.			
M.			
K.			
Mz.			
Me.			
V.			
S.			
S.			
A	<u>3321</u>		
R.			
PE.			
G.			
TD.	<u>3323</u>		

Loc. in Sec. NE SE SE
 Geol. _____
 Contr. _____
 Peel Bros. Tools

Pool
Odin

ABANDONED	
DEC 13 '56	0

Log

No.

Sec.

T.

R.

Date Comm. spd. 10-28-56

8" @ 310 w/175, Drlg. 360 NOV 7 '56

5 1/2 @ 3322 1/2 w o c t NOV 13 '56 NOV 21 '56

DD in NOV 28 '56 X DEC 5 '56 DEC 12 '56 CO

DD 3343 1/2 TD no show tst wth

PB 3337 1/2 A \$ 1/4 Buph

+ 2 Buph PB 3325 1/2 A \$ 2

Buph

DEW