


Ellis

KANSAS

SECTION 2 TOWNSHIP 13S RANGE 17W

WELL NO. #1 Staab

COMPANY Nadel-Gussman

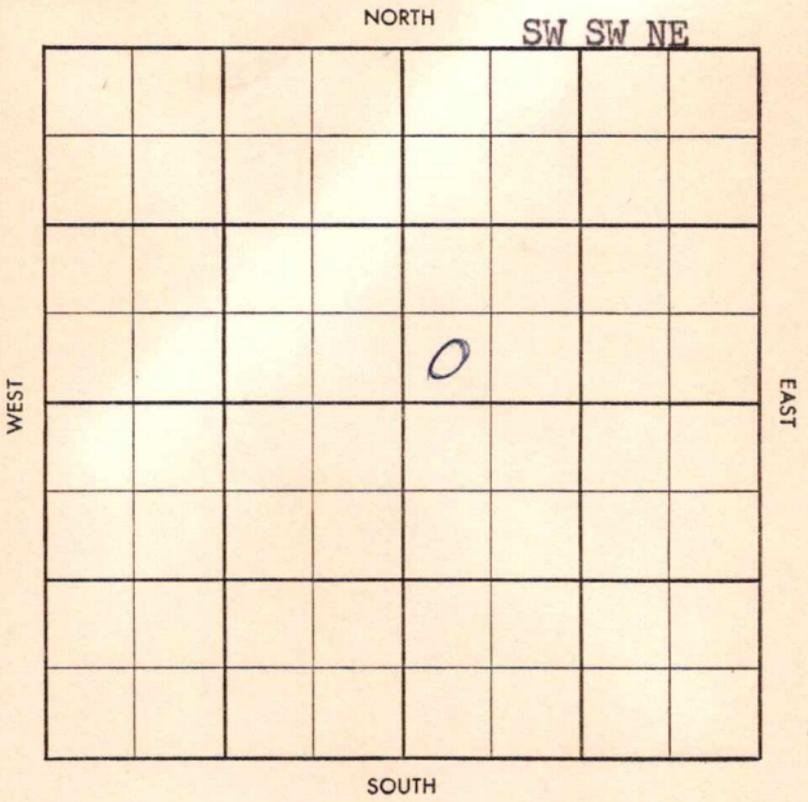

180917

~~180917~~
~~180917~~

S-513-B

County Ellis Elev. _____
 Sec. 2 wp. 13 Rge. 17W
 Company Nadel-Gussman
 Farm Name Staab No. 1

TOPS	DEPTH	LOG	DATUM
Anh.			
Tp.			
H.			
Tr.			
Dg.			
B.L.			
L.			
K.C.			
B.K.C.			
Ce.			
C.			
M.			
M.			
K.			
Mz.			
Mq.			
V.			
S.			
S.			
A.			
R.			
Pf.			
G.			
T.D.			

Loc. in Sec. SW SW NE
 Geol. _____
 Contr. _____
Reserve Drlg
 Pool _____
Catherine

APR 16 1938
FIRST REPORT

Date Comm. _____
MIRT

Co.
 No.
 Sec.
 T.
 R.

Twp. ~~-----~~ Pool ~~-----~~

Co. ~~-----~~ Facet ~~-----~~

S-513-B

County Ellis Elev. 225 200 4056 88
 Sec. 2 wp. 13 Rge. 17W
 Company Nadel-Gussman
 Farm Name Staab No. 1

TOPS	DEPTH	LOG	DATUM
Anh.			
Tp.	3089		
H.	3269		
Tr.	3288		
Dg.			
B.L.			
L.	3316		
K.C.			
B.K.C.			
Ce.			
C.	3580		
M.			
M.			
K.			
Mz.			
Mq.			
V.			
S.			
S.			
A.	3593		
R.			
Pf.			
G.			
T.D.	3597		

Loc. in Sec. SW SW NE
 Geol. Reserve Drlg
 Contr. Catherine
 Pool COMPLETE
 No. 0
 JUN 1 '58

Date Comm. 4-15-58
 MIRT APR 23 '58 8" 202/150 DST 3332-53
 1hr 60' Hoogem 60' MCO BHP 960/20
 d 3300 APR 30 '58 DST 3360-75 1hr 215
 gray oil BHP 720/30" DST 3377-3400
 2hrs 5' oil 180' MCO BHP 720/30"
 5" 3437 woc MAY 7 '58 24/3385-89
 24/3359-63 \$ 3/4 BOPH net 3500A
 \$ 1380 PH NW 5 hrs POP MAY 14 '58
 MAY 21 '58 MAY 25 '58 JUN 3 '58 JUN 11 '58 PhyP 268 BOPD
 NW