

Ellis 16^W

Map No. Sec. 24 Twp. 12 R.

Well No. 1 Farm

KANSAS
Schmidtberger
Wolfe Creek stat


Company

NORTH

(Schmidtberger)

WEST

EAST

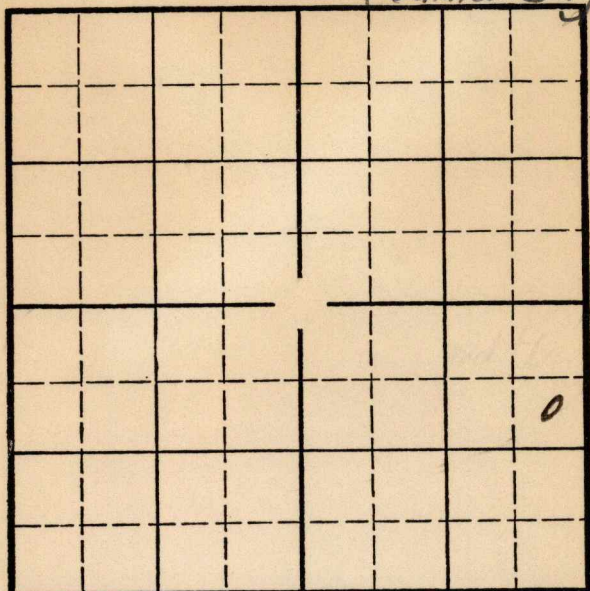

SOUTH

Location
Drilling Remarks

Rig Up
Drilling Remarks

RECORD

PRODUCTION

Cased in. ft.
Sand
Gas
Oil
Total Depth

1st 24 hrs. Nat.
1st 24 hrs. after shot
Gas cu. ft.
Dry Hole
Abandoned

Ellis

Map No. 24 Sec. 12 Twp. 16 R. 16

Well No. 1 - Schmidtberger Farm


Wolf Creek etc Company

990 Ft. from N. Line

 Ft. from S. Line

330 Ft. from E. Line

 Ft. from W. Line

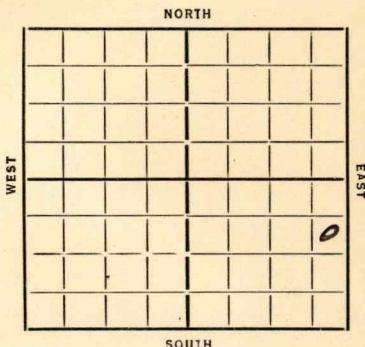

Elev. 1876

Date 1/3/5 REPORT

1/20 Rig

1/29 Rd

12/6 —

12/13 Spud 460 15" 410

12/19 Dlg 700 12" 690

12/26 " 1950

12/26 " 2370

1/10 HFW 2615-30 8" 2670

 Dlg 2715

1/17 8" 2780 to 3032 6" 3087

 Dlg 3110

1/24 Qw. 3108 to 3085 6" 3295

1/31 Granite 3509 TD 3510 SD.

2/5 Granite 3509

 TD 3510

N.P.A.

ABANDONED

KANSAS

Map No. 71 Sec. 24 Twp. 12 R. 16WWell No. 1-SchmidtbergerWolfe Creek etal Company

Contractor

FIRST REPORTS

SECTION PLAT

			0

990 Ft. from N. Line

Ft. from S. Line

330 Ft. from E. Line

Ft. from W. Line

Location

Rig up

Drilling and Remarks:

Rig

RECORD

Cased in., ft.

Sand

Gas

Oil

Total Depth

PRODUCTION

1st 24 hrs. Nat.

1st 24 hrs. after shot

Gas Cu. Ft.

Dry Hole

Abandoned

Date

11-20-35 192

ORVAL MANNSCHRECK

Scout

KANSAS

Map No. 71 Sec. 24 Twp. 12 R. 16W

Well No. 1 - Schmudtger
Wolfe Creek et al Company

Contractor

SECTION PLAT

990 Ft. from N. Line

..... Ft. from S. Line

330 Ft. from E. Line

..... Ft. from W. Line

			0

COMPLETED

Location.....

Rig up.....

Drilling and Remarks:

RECORD

Cased..... in., ft.

~~Sand~~ Granite - 3509

Gas.....

Oil.....

Total Depth 3510

PRODUCTION

1st 24 hrs. Nat.....

1st 24 hrs. after shot.....

Gas..... Cu. Ft.

Dry Hole.....

Abandoned.....

Date

FEB 5 1936

ORVAL MANNSCHRECK

192..... Scout