


Section 9 Township 33 Range 3E

Well No. 1 Potts

Company Deep Rock
Misc.

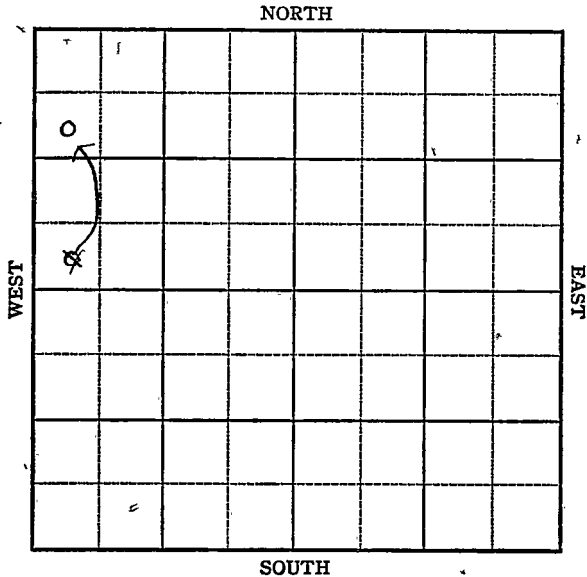

Sec. 9 Twp. 33 R. 3-E ✓


Well No. #1 Potts Farm
Deep Rock Company
Miscellaneous

990 Ft. from N. Line

330 Ft. from S. Line

_____ Ft. from E. Line

330 Ft. from W. Line

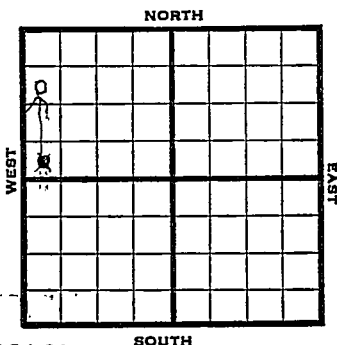

SW NW NW Elev. 1142'

1947

REPORT

3/19 R U R

3/25 10" @ 110'
Drlg 1895'

4/2 2305' Fsg.

4/9 Drlg. 2840'

3522
1142
2380

4/15 Mississippi 3185'
Arbuckle 3522'
TD 3528'
SDO

4/23 Arb 3522
TD 3550'

ABANDONED

Map No. 1 Sec. 9 Twp. 33 R. 3E

Well No. 1 Potts

Deep Rock Company

FIRST REPORT Contractor

SW NW

SECTION PLAT

 Ft. from N. Line

330 Ft. from S. Line

 Ft. from E. Line

330 Ft. from W. Line

Cowley County

Location

Rig up

Drilling and Remarks:

R U R

RECORD

Cased in., ft.

Sand

Gas

Oil

Total Depth

PRODUCTION

1st 24 hrs. Nat.

1st 24 hrs. after shot

Gas Cu. Ft.

Dry Hole

Abandoned

Date

MAR 1 9 1947

19

S. J. LEWIS

Scout

KANSAS

Map No. K1 Sec. 9 Twp. 33 R. 3E

Well No. 1 Potts

Deep Rock

Company

CORRECTION

Contractor

SW NW NW


SECTION PLAT

990 Ft. from N. Line

 Ft. from S. Line

 Ft. from E. Line

330 Ft. from W. Line

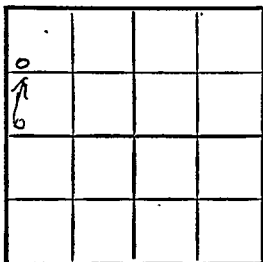

Cowley County

Location _____

Rig up _____

Drilling and Remarks:

Reported

SW NW

RECORD

Cased _____ in., _____ ft.

Sand _____

Gas _____

Oil _____

Total Depth _____

PRODUCTION

1st 24 hrs. Nat. _____

1st 24 hrs. after shot _____

Gas _____ Cu. Ft.

Dry Hole _____

Abandoned _____

Date

MAR 26 1947 19

S. J. LEWIS Scout

Map No. 1 Sec. 9 Twp. 33 R. 3E

Well No. 1 Potts

Deep Rock

Company

~~ABANDONED~~

Contractor

SW NW NW

E 11142
SECTION PLAT

990 Ft. from N. Line

_____ Ft. from S. Line

_____ Ft. from E. Line

330 Ft. from W. Line

o			

Cowley County

Location _____

Rig up _____

Drilling and Remarks:

Cur 3022

RECORD

Cased _____ in., _____ ft.

Sand _____

Gas _____

Oil _____

Total Depth 1955

PRODUCTION

1st 24 hrs. Nat. _____

1st 24 hrs. after shot _____

Gas _____ Cu. Ft.

Dry Hole _____

Abandoned _____

Date

APR 23 1947 19 _____ S. J. LEWIS Scout