

KANSAS

FORM 51 25M 3-49 PETROL

Cowley

Section 9 Township 33 Range 3E

Well No. 1 Parsons

Company Ben Gralapp

Misc.

NORTH

WEST

		o					

EAST

SOUTH

KANSAS

Cowley

Sec. 9 Twp. 33 R. 3E ☒

Well No. #1 Parsons Farm

Ben Gralapp Company

Miscellaneous


 Ft. from N. Line

330' Ft. from S. Line

990' Ft. from E. Line

 Ft. from W. Line

SW SE NW

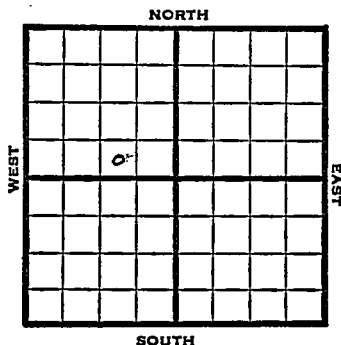

1949

Elev 1150' REPORT

5/4 8" @ 130'
Drlg. 1387'

5/10 KC 2717'
Drlg. 3075'

5/18 Miss 3179'
Simp 3517-19'
TD 3519'
5" @ 3519'

5/25 "

6/1 TD 3520'
No Simp
Arb. 3517'
5" @ 3519'
500 acid
Pump 50 Oil Pot
38° Gr.
Comp

COMPLETED

Map No. _____ Sec. 9 Twp. 33 R. 3E

Well No. 1 Parsons

Ben Gralapp Company

FIRST REPORT

Contractor

SW SE NW


SECTION PLAT

_____ Ft. from N. Line

330 Ft. from S. Line

990 Ft. from E. Line

_____ Ft. from W. Line

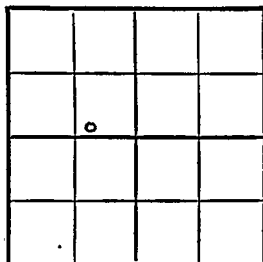

Cowley County

RECORD

Location _____

Cased _____ in., _____ ft.

Rig up _____

Sand _____

Drilling and Remarks:

Gas _____

8" @ 130

Oil _____

drlg. 1387

Total Depth _____

PRODUCTION

1st 24 hrs. Nat. _____

1st 24 hrs. after shot _____

Gas _____ Cu. Ft.

Dry Hole _____

Abandoned _____

Date

MAY 4 1949 19

S. J. LEWIS Scout

Kansas

Map No. K1 Sec. 9 Twp. 33 R. 3EWell No. 1 ParsonsBen Gralapp

Company


COMPLETE

Contractor

SW SE NW

E1, 1150

SECTION PLAT

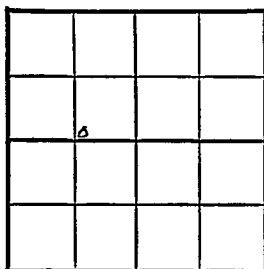 Ft. from N. Line330 Ft. from S. Line990 Ft. from E. Line Ft. from W. Line

Cowley County

Location

Rig up

Drilling and Remarks:

*No Log**QX 3517**5' @ 3519**500 acid**Pump 500 oil 20 ft**3520 ft*

RECORD

Cased in., ft.Sand Gas Oil Total Depth 3520

PRODUCTION

1st 24 hrs. Nat. 1st 24 hrs. after shot Gas Cu. Ft.Dry Hole Abandoned

Date

JUN 1 1940 19S. J. LEWIS

Scout