


Section 9 Township 33 Range 3E

Well No. #3 Parsons

Company Martin Wunderlich

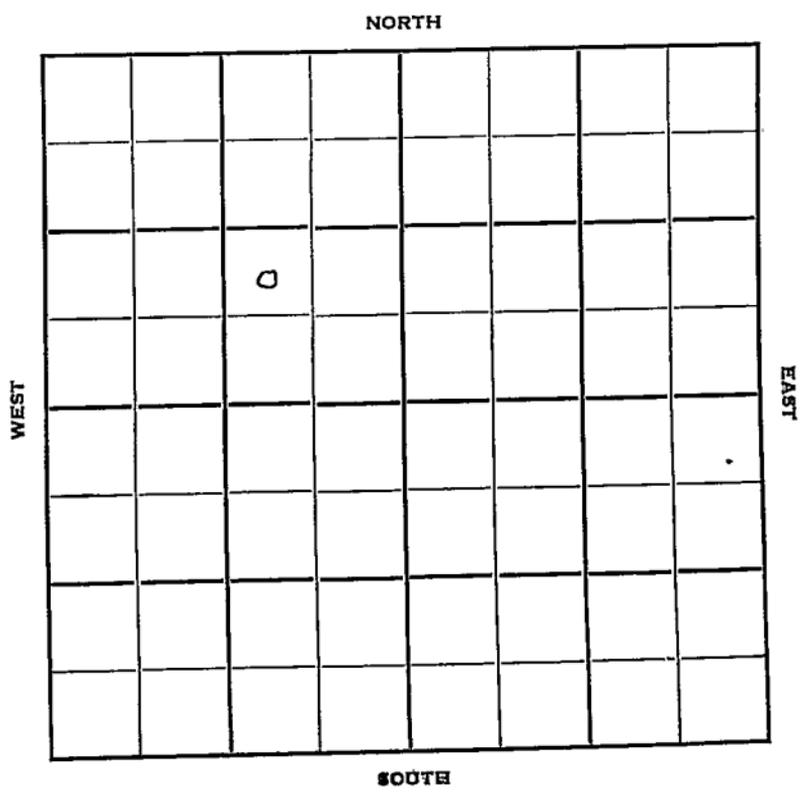

Cowley

KANSAS

Sec. 9 Twp. 33 R. 3E

Well No. #3 Parsons Farm

Martin Wunderlich Company

Graham Contractor


Ft. from N. Line

990 Ft. from S. Line

990 Ft. from E. Line

Ft. from W. Line

NW SE NW

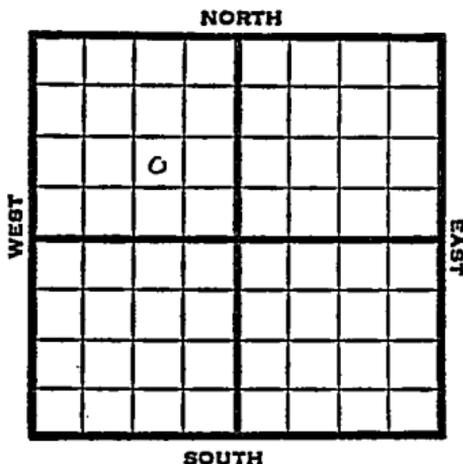

1951 Elev. 1161 REPORT

10/10 Location

11/7 Oil Well TD 3533
 10" @ 104 KC 2743
 Miss 3192 Arb. 3531
 5" @ 3531 TD 3533
 160 A Comp. 50 bopd

COMPLETED

