

Map No.

KANSAS

Sec.

19

Typ.

30

R.

Cowley 4E

Well No.

3-Hansen
New Oil

(Houser)


Farm

Company

NORTH

WEST

EAST

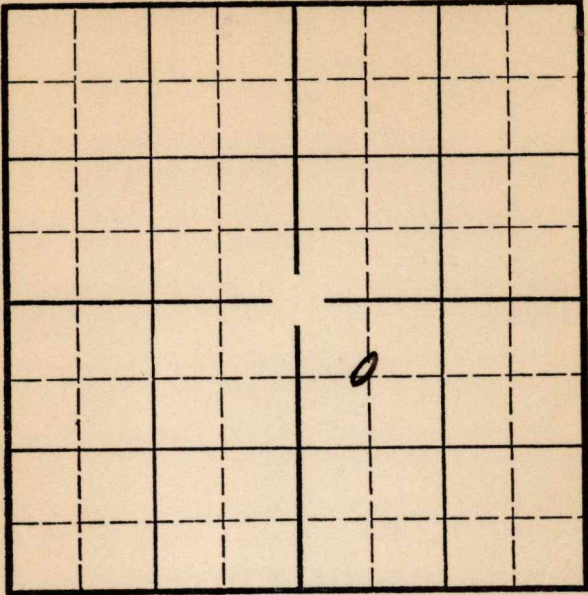

SOUTH

Location _____
Drilling Remarks _____

Rig Up _____
Drilling Remarks _____

RECORD

Cased _____ in. _____ ft.
Sand _____
Gas _____
Oil _____
Total Depth _____

PRODUCTION


1st 24 hrs. Nat. _____
1st 24 hrs. after shot _____
Gas _____ cu. ft. _____
Dry Hole _____
Abandoned _____

Cowley 14E

Map No. Sec. 19 Twp. 30 R.

Well No. 3- Hansen Farm
Green Oil Company

660 Ft. from N. Line
 Ft. from S. Line
 Ft. from E. Line
610 Ft. from W. Line

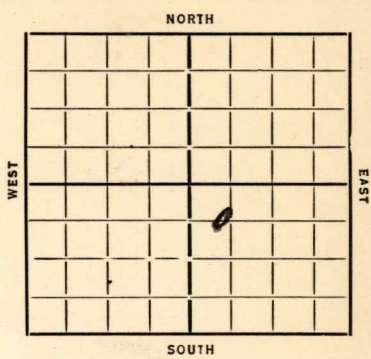

Elev. 1161

Date	REPORT
1935	
10/9	B. R.
11/1	20" 59 15" 215
	alg 375
11/7	alg 1210 12" 1187
11/14	" 1950 10" 1706
11/21	8" 2196
11/29	—
12/6	Top Part 2855 6" 2855
	TD 2861 P.P.P 8.0
12/13	—
12/18	Sand 2855
	TD 2873
	20 ft 328 Halls.

COMPLETED

KANSAS

Map No. 11 Sec. 19 Twp. 30 R. 4E

Well No. 3-Hansen

Trees oil Company

Contractor

COMPLETE

SECTION PLAT

660 Ft. from N. Line

..... Ft. from S. Line

..... Ft. from E. Line

610 Ft. from W. Line

		0	

Location.....

Rig up.....

Drilling and Remarks:

20 fts

328 bbls

RECORD

Cased..... in., ft.

Sand 2855

Gas.....

Oil.....

Total Depth 2873

PRODUCTION

1st 24 hrs. Nat.....

1st 24 hrs. after shot.....

Gas..... Cu. Ft.

Dry Hole.....

Abandoned.....

Date

ORVAL MANNSCHRECK

12-18-35 192.....

Scout

KANSAS

Map No. 11 Sec. 19 Twp. 30 R. 4E

Well No. 3-Hanser

Trues oil Company

Contractor

FIRST REPORTS

SECTION PLAT

660 Ft. from N. Line

..... Ft. from S. Line

..... Ft. from E. Line

610 Ft. from W. Line

		0	

Location.....

Rig up.....

Drilling and Remarks:

BK

RECORD

Cased..... in., ft.

Sand.....

Gas.....

Oil.....

Total Depth.....

PRODUCTION

1st 24 hrs. Nat.....

1st 24 hrs. after shot.....

Gas..... Cu. Ft.

Dry Hole.....

Abandoned.....

Date

ORVAL MANNSCHECK

10-9-35 192.....

Scout