


Section 19 Township 30 Range 4-E

Well Number #3-Little (Littell)

Company Trees Oil

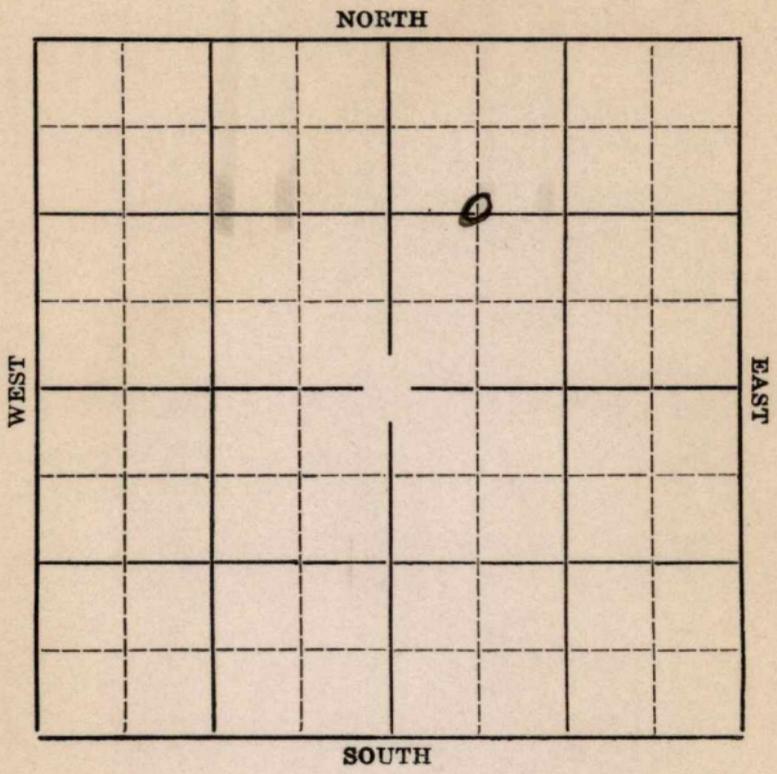

Map No. **KANSAS** Sec. **19** Twp. **30** R. **4E**

Well No. **#3 Little** Farm


**Trees Oil Co.** Company

**1320'** Ft. from N. Line

\_\_\_\_\_ Ft. from S. Line

\_\_\_\_\_ Ft. from E. Line

**660'** Ft. from W. Line

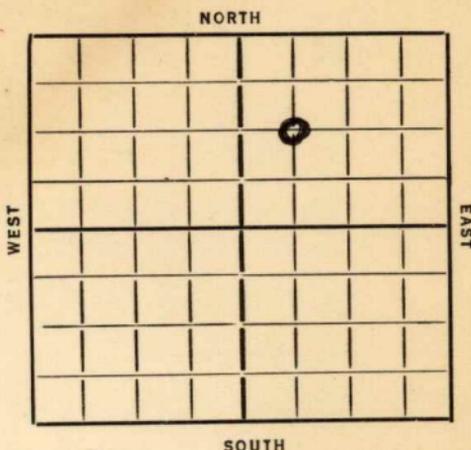

**Elev. 1161**

Date	REPORT
<b>1936</b>	
8/12	Rig on ground.
8/20	Rig.
8/27	Rigging up
9/3	15" @ 186'. Drlg. 490'.
9/10	Shut down.
9/18	10" @ 1705'. Drlg. 1855'.
9/24	Drilling 2290'.
10/1	5" @ 2830'. Drlg.
10/8	<b>Bartlesville 2860-2890'</b> . Shot 60
	qts. 2000' of oil.
10/15	-Swabbed 247 bbls in 24 hours.
10/22	---
10/28/36	<b>-Bart 2860'</b> .
	T.D. 2890'.
	Shot 60 qts.
	Potential 237 bbls.

**COMPLETED**

**KANSAS**

Map No. W Sec. 19 Twp. 30 R. 4E

Well No. 3 Little

Trees Oil

Company \_\_\_\_\_

Contractor \_\_\_\_\_

**SECTION PLAT**

		●	

1320 Ft. from N. Line

\_\_\_\_\_ Ft. from S. Line

\_\_\_\_\_ Ft. from E. Line

660 Ft. from W. Line

**COMPLETED**

Location \_\_\_\_\_

Rig up \_\_\_\_\_

Drilling and Remarks:

Bar 82860

Shot 609 to

PO 8237

**RECORD**

Cased \_\_\_\_\_ in., \_\_\_\_\_ ft.

Sand \_\_\_\_\_

Gas \_\_\_\_\_

Oil \_\_\_\_\_

Total Depth 2890

**PRODUCTION**

1st 24 hrs. Nat. \_\_\_\_\_

1st 24 hrs. after shot \_\_\_\_\_

Gas \_\_\_\_\_ Cu. Ft.

Dry Hole \_\_\_\_\_

Abandoned \_\_\_\_\_

Date

OCT 28 1936

19

**S. J. LEWIS**

Scout

*Cowley*  
Map No. 111 Sec. 19 Twp. 30 R. 4E

Well No. 3 Little  
Green Oil Company

Contractor

**SECTION PLAT**

		●	

1320 Ft. from N. Line

\_\_\_\_\_ Ft. from S. Line

\_\_\_\_\_ Ft. from E. Line

660 Ft. from W. Line

FIRST REPORT

Location \_\_\_\_\_

Rig up \_\_\_\_\_

Drilling and Remarks:

*ROG*

**RECORD**

Cased \_\_\_\_\_ in., \_\_\_\_\_ ft.

Sand \_\_\_\_\_

Gas \_\_\_\_\_

Oil \_\_\_\_\_

Total Depth \_\_\_\_\_

**PRODUCTION**

1st 24 hrs. Nat. \_\_\_\_\_

1st 24 hrs. after shot \_\_\_\_\_

Gas \_\_\_\_\_ Cu. Ft.

Dry Hole \_\_\_\_\_

Abandoned \_\_\_\_\_

Date

AUG 12 1936 19

S. J. LEWIS Scout