


Section 19 Township 30 Range 4-E

Well Number #1 Pierson

Company Trees Oil

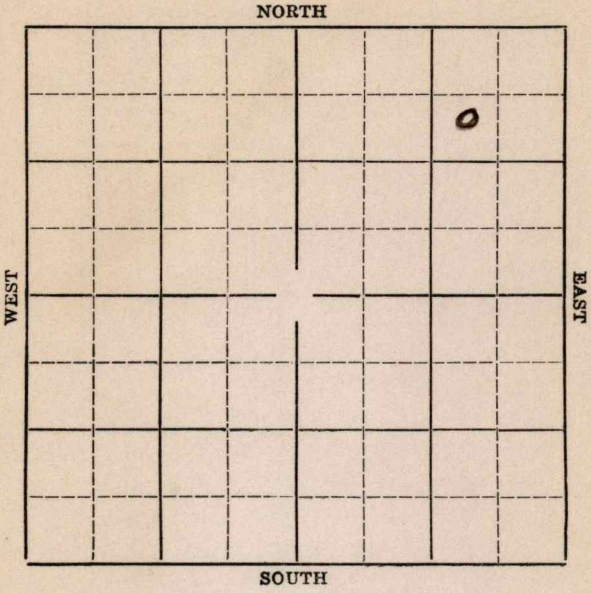

**KANSAS**

Cowley

Sec. 19 Twp. 30 R. 4E

Well No. #1 Pierson Farm


Trees Oil. Company

990' Ft. from N. Line

         Ft. from S. Line

990' Ft. from E. Line

         Ft. from W. Line

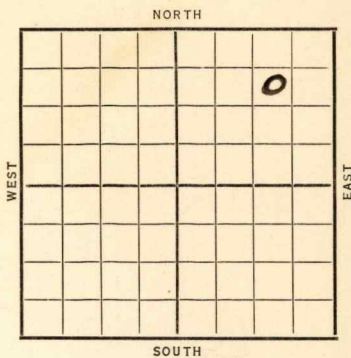

**Elev. 1158**

Date	REPORT
10/21	Rig.
10/29	Rigging up;
11/6	15" @ 186 Drlg. 325
11/12	Drlg. 1200
11/19	12" @ 1186'. Drlg. 1250'.
11/27	Drlg. 2020'.
12/3--	<b>K.C. 2325'. Drlg. 2480'.</b>
12/10	Drlg. 2810'.
12/17	<b>Bart Sd. 3852-72'. T. D. 2893</b>
12/22	<b>Bart. Sd. 2852-72'.</b>
	5 qts. shot. T. D. 2893'.
	50 bbls.
	<b>COMPLETED</b>

Map No. J 11 Sec. 19 Twp. 30 R. 4E

Well No. 1 Pierson

Tree Oil Company

Contractor

SECTION PLAT

990 Ft. from N. Line

\_\_\_\_\_ Ft. from S. Line

990 Ft. from E. Line

\_\_\_\_\_ Ft. from W. Line

			o

FIRST REPORT

Location \_\_\_\_\_

Rig up \_\_\_\_\_

Drilling and Remarks:

Rig

RECORD

Cased \_\_\_\_\_ in., \_\_\_\_\_ ft.

Sand \_\_\_\_\_

Gas \_\_\_\_\_

Oil \_\_\_\_\_

Total Depth 211 4-133-779

PRODUCTION

1st 24 hrs. Nat. \_\_\_\_\_

1st 24 hrs. after shot \_\_\_\_\_

Gas \_\_\_\_\_ Cu. Ft.

Dry Hole \_\_\_\_\_

Abandoned \_\_\_\_\_

Date

OCT 21 1936

S. J. LEWIS

Scout

Map No. J 11 Sec. 19 Twp. 30 R. 4E

Well No. 1 Pierson

Greens Oil Company

Contractor

SECTION PLAT

990 Ft. from N. Line

\_\_\_\_\_ Ft. from S. Line

990 Ft. from E. Line

\_\_\_\_\_ Ft. from W. Line

			0

COMPLETED

Location \_\_\_\_\_

Rig up \_\_\_\_\_

Drilling and Remarks:

*Bart. Sol 2852-72*  
*59 to Shot*  
*50 yds.*

RECORD

Cased \_\_\_\_\_ in., \_\_\_\_\_ ft.

Sand \_\_\_\_\_

Gas \_\_\_\_\_

Oil \_\_\_\_\_

Total Depth 2893

PRODUCTION

1st 24 hrs. Nat. \_\_\_\_\_

1st 24 hrs. after shot \_\_\_\_\_

Gas \_\_\_\_\_ Cu. Ft.

Dry Hole \_\_\_\_\_

Abandoned \_\_\_\_\_

Date

DEC 22 1936

19

S. J. LEWIS

Scout