

KANSAS

Cowley

Section 20 Township 30 Range 4E

Well No. #4 Mueller

Company C R A

Miscellaneous

NORTH

WEST

EAST

Q:

SOUTH

KANSAS Cowley

Sec. 20 Twp. 30 R. 4E

Well No. #4 Mueller Farm

C. R. A. Company

Misc.


Ft. from N. Line

260 Ft. from S. Line

1166 Ft. from E. Line

Ft. from W. Line

SW SE SE

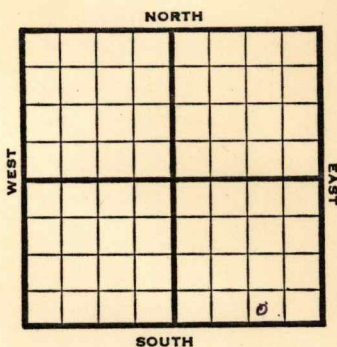

1948

Elev. 1165'

REPORT

4/7

RUR

4/14

8" @ 49'

Drlg. 2062'

4/21

Bart 2795'

5" @ 2796'

TD 2805'

4/28

TD 2812'

Swb. 9 bbls. oil in 17 hrs.

5/5

Bart 2795'

5" @ 2796'

Pump 35 oil Pot.

Gr. 38°

TD 2805'

COMPLETED

Map No. _____ Sec. 20 Twp. 30 R. 4E

Well No. 4 Mueller

C R A Company

FIRST REPORT Contractor

SW SE SE


SECTION PLAT

_____ Ft. from N. Line

260 Ft. from S. Line

1166 Ft. from E. Line

_____ Ft. from W. Line

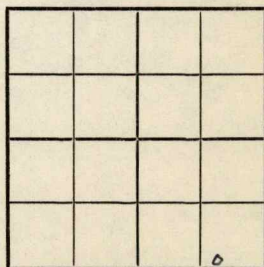

Cowley County

Location _____

Rig up _____

Drilling and Remarks:

R U R

RECORD

Cased _____ in., _____ ft.

Sand _____

Gas _____

Oil _____

Total Depth _____

PRODUCTION

1st 24 hrs. Nat. _____

1st 24 hrs. after shot _____

Gas _____ Cu. Ft.

Dry Hole _____

Abandoned _____

Date

APR 7 1948

19

S. J. LEWIS

Scout

Map No. 11 Sec. 20 Twp. 30 R. 4E

Well No. 4 Mueller

C R A Company

COMPLETE Contractor

SW SE SE

E 1/165
SECTION PLAT

 Ft. from N. Line

2600 Ft. from S. Line

1166 Ft. from E. Line

 Ft. from W. Line

Cowley County

Location

Rig up

Drilling and Remarks:

Box 42795

5" C 2796

Pump 3500 ft

380 ft

RECORD

Cased in., ft.

Sand

Gas

Oil ✓

Total Depth 2805

PRODUCTION

1st 24 hrs. Nat.

1st 24 hrs. after shot

Gas Cu. Ft.

Dry Hole

Abandoned

Date

MAY 5 1948 19 S. J. LEWIS Scout