


Section 20 Township 30 Range 4 E

Well No. #1 James A. West.

Company W.W. West

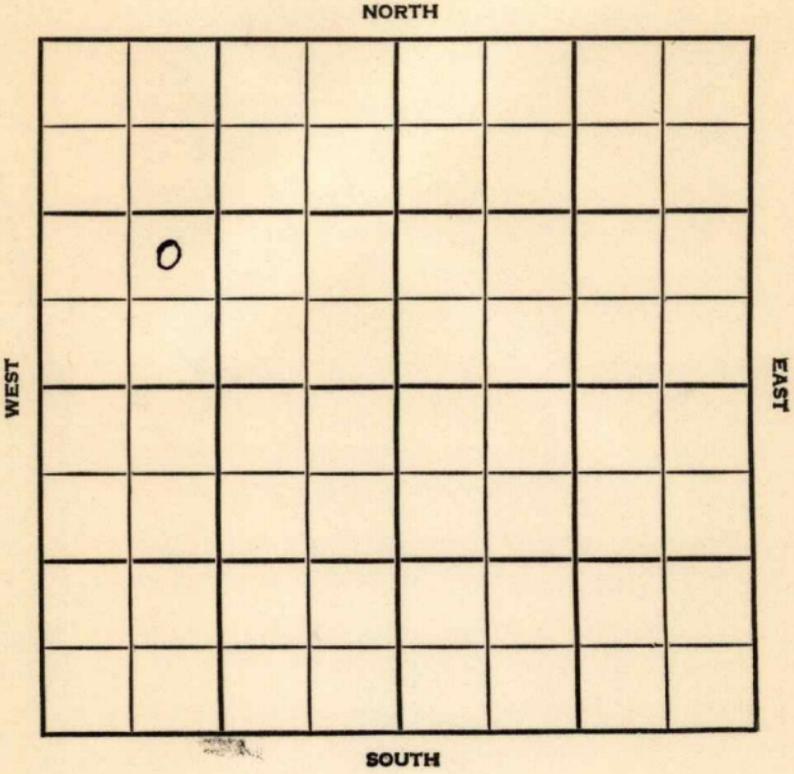

Cowley

SEC. 20	TWP. 30	R. 4E
WELL NO. #1-James A. West		
COMPANY W.W. West		FARM
CONTRACTOR Rock		


_____ Ft. from N. Line

_____ Ft. from S. Line

_____ Ft. from E. Line

_____ Ft. from W. Line

NW SW NW

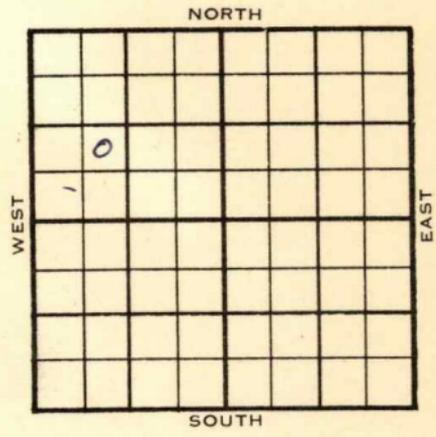

	ELEVATION	REPORT
--	-----------	--------

1955

1163'

8-31 5" @ 2875 40/ 2835-45 sd-frac
 Comp. 4 bopd

<u>Tops:</u>	<u>Depth</u>
Stal.	1938
K.C. xx	2296
Oswego	2458
Bart.	2823
Bart. sd.	2824
T.D. 2875'	

FIRST REPORT

COMPLETED

County ~~Cowley~~ Elev. 1163
 Sec. 20 Twp. 30 Rge. LE
 Company W. W. West
 Farm Name James A. West No. 1

TOPS	DEPTH	LOG	DATUM	Loc. in Sec.
Anh.				NW SW NW
Tp.				
H.				
Tr.				
Dg.				
B.L.				
L. Stal.	1938			Geol.
K.C.	2296			Contr.
B.K.C.				
Ce. Oswego	2458			
C. Bart.	2823			
M. Bart. sd.	2834			Pool
M.				Rock
K.				
Mz.				
Me.				
V.				
S.				
S.				
A.				
R.				
PE.				
G.				
T.D.	2875			

6
 COMPLETE
 FIRST REPORT
 AUG 31 '55

Date Comm.

5" @ 2875 40/ 2835-45 sd-frac
 Comp. 4 bopd

Co.

Lse.

No.

Sec.

T.

R.