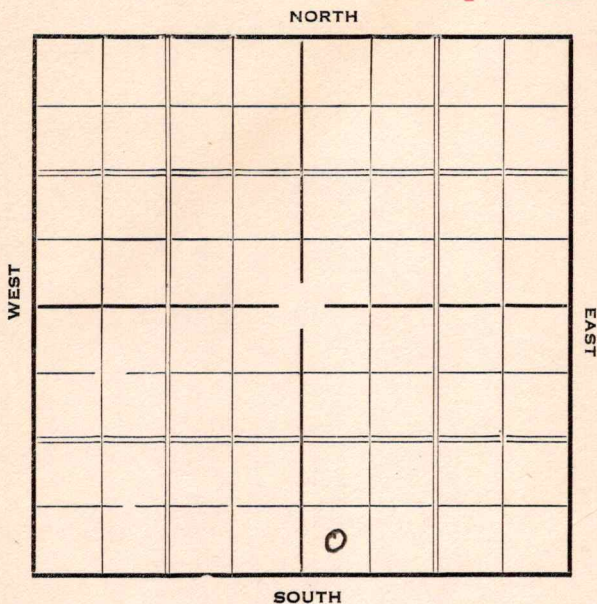


Well Number. 1 ~~E. Watter~~

Company.....Gulf.....

Special

15



**KANSAS**

Ellis

Map No. .... Sec. 3 Twp. 13 R. 17WWell No. #1 ~~E. Watter~~ MESSICK Farm

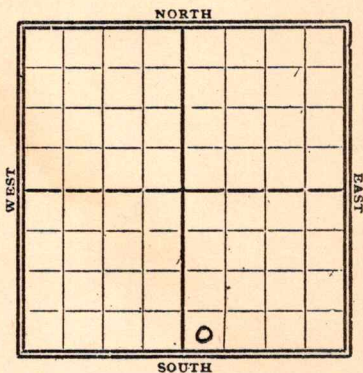
Gulf

Company

..... Ft. from N. Line

330 Ft. from S. Line

..... Ft. from E. Line

330 Ft. from W. Line**SPECIAL**

| Date  | REPORT                                      |
|-------|---------------------------------------------|
| 1936  | Elev. 2015 <b>SPECIAL</b>                   |
| 12-9  | Rig Cable                                   |
| 12/17 | 15" @ 148'. Drlg. 400'.                     |
| 12/24 | Drlg. 2640'.                                |
| 12/29 | Oswald 3271' set 7".                        |
|       | T. D. 3275' RUST.                           |
| 1937  |                                             |
| 1/7   | T. D. 3300'. 700' oil in hole.              |
| 1/14  | T. D. 3350'. 600' water & 700' oil in hole. |
| 1/21  | Cored 3367-72'. Drlg. 3410'.                |
| 1/28  | " " " " "                                   |
| 2/4   | TD 3428, 2000 acid Potential                |
|       | 231 oil 10 water, 5000 acid. No test        |
|       |                                             |
| 2/10  | Oswald 3271'.                               |
|       | T. D. 3428'.                                |
|       | Acidize 2000. Acidize 5000.                 |
|       | Pump 432 oil & 31 water.                    |
|       | <b>COMPLETED</b>                            |

KANSAS

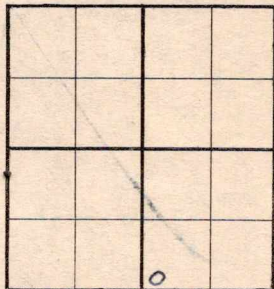
Map No. 71 Sec. 3 Twp. 13 R. 17WWell No. 1 F. Matter

Company

Contractor

Special

## SECTION PLAT

       Ft. from N. Line330 Ft. from S. Line       Ft. from E. Line330 Ft. from W. Line

## FIRST REPORT

Location                     Rig up                     

Drilling and Remarks:

Rig O.K.

## RECORD

Cased            in.,            ft.Sand                     Gas                     Oil                     Total Depth                     

## PRODUCTION

1st 24 hrs. Nat.                     1st 24 hrs. after shot                     Gas                      Cu. Ft.Dry Hole                     Abandoned                     

Date

DEC 9 1936

19

S. J. LEWIS Scout

KANSAS

Map No. 71 Sec. 3 Twp. 13 R. 17WWell No. 1 MessickGulf. Company

Contractor

## SECTION PLAT

|  |  |  |  |
|--|--|--|--|
|  |  |  |  |
|  |  |  |  |
|  |  |  |  |
|  |  |  |  |

       Ft. from N. Line330 Ft. from S. Line       Ft. from E. Line330 Ft. from W. Line

## CORRECTION

Location       Rig up       

Drilling and Remarks:

*Reputed as*  
*No. 1, F. Walter*

## RECORD

Cased        in.,        ft.Sand       Gas       Oil       Total Depth       

## PRODUCTION

1st 24 hrs. Nat.       1st 24 hrs. after shot       Gas        Cu. Ft.Dry Hole       Abandoned       

Date

DEC 16 1936

19

S. J. LEWIS

Scout

**KANSAS**Map No. \_\_\_\_\_ Sec. 3 Twp. 13 R. 17WWell No. 1 Messick

Company \_\_\_\_\_

Contractor \_\_\_\_\_

**SECTION PLAT**

|  |  |  |  |
|--|--|--|--|
|  |  |  |  |
|  |  |  |  |
|  |  |  |  |
|  |  |  |  |

\_\_\_\_\_ Ft. from N. Line

330 Ft. from S. Line

\_\_\_\_\_ Ft. from E. Line

330 Ft. from W. Line**COMPLETED**

Location \_\_\_\_\_

Rig up \_\_\_\_\_

Drilling and Remarks:

Oswald 32712000 acid5000 "Pump 432 oil31 water**RECORD**

Cased \_\_\_\_\_ in., \_\_\_\_\_ ft.

Sand \_\_\_\_\_

Gas \_\_\_\_\_

Oil \_\_\_\_\_

Total Depth 3428**PRODUCTION**

1st 24 hrs. Nat. \_\_\_\_\_

1st 24 hrs. after shot \_\_\_\_\_

Gas \_\_\_\_\_ Cu. Ft.

Dry Hole \_\_\_\_\_

Abandoned \_\_\_\_\_

Date

FEB 10 1937

19

S. J. LEWIS Scout