

KANSAS Ellis County

FORM 51 5M PETROL

Section 3 Township 13 Range 17W

Well No. 2 Messick

Company Gulf

NORTH

16

SOUTH

WEST

EAST

0

KANSAS

Ellis

Sec. 3 Twp. 13 R. 17W

Well No. 2 Messick Farm

Gulf Company

Sugar Loaf

Ft. from N. Line

990


Ft. from S. Line

990

Ft. from E. Line

Ft. from W. Line

NW SE SE Elev. 2037

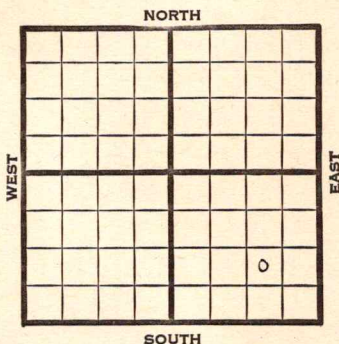

1945

R E P O R T

5/16

RUR

5/24

Anhy 1221

8" @ 1227' WOC

5/31

Drlg. 2485

6/13

Arb 3713

5" @ 3533'

TD 3728'

ABANDONED

Kansas Pool Name Sugar Loaf

Map No. 71 Sec. 3 Twp. 13 R. 17W

Well No. 2 Messick

Gulf Company

FIRST REPORT Contractor

NW SE SE

SECTION PLAT

 Ft. from N. Line

990 Ft. from S. Line

990 Ft. from E. Line

 Ft. from W. Line

			o

Ellis

Location

Rig up

Drilling and Remarks:

RUR

RECORD

Cased in., ft.

Sand

Gas

Oil

Total Depth

PRODUCTION

1st 24 hrs. Nat.

1st 24 hrs. after shot

Gas Cu. Ft.

Dry Hole

Abandoned

Date

MAY 16 1945 19

S. J. LEWIS Scout

Kansas Pool Name Sugar LoafMap No. 71 Sec. 3 Twp. 13 R. 17WWell No. 2 MessickGulf Company

ABANDONED

Contractor

NW SE SE

E/2037
SECTION PLAT Ft. from N. Line990 Ft. from S. Line990 Ft. from E. Line Ft. from W. Line

			0

Ellis County

Location Rig up

Drilling and Remarks:

CR 83713
5" @ 3533

RECORD

Cased in., ft.Sand Gas Oil Total Depth 3728

PRODUCTION

1st 24 hrs. Nat. 1st 24 hrs. after shot Gas Cu. Ft.Dry Hole Abandoned

Date

JUN 13 1945 19S. J. LEWIS Scout