


Section 8 Township 17 Range 12W

Well No. #1 Klug

Company D. T. Ingling

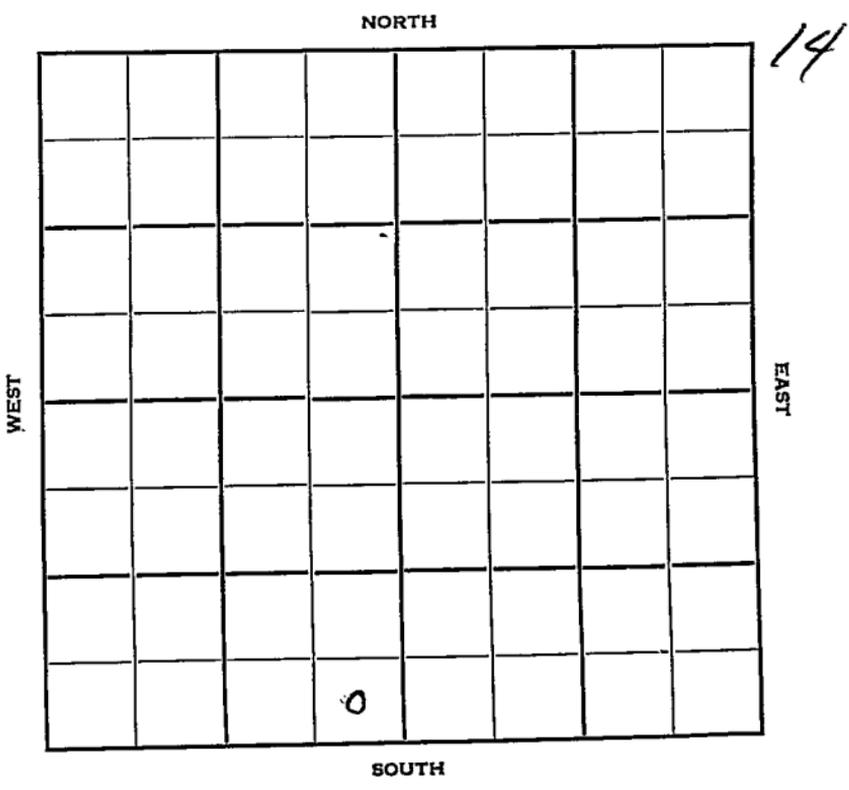

Sec. 8 Twp. 17 R. 12 W

Well No. # 1 Klug Farm

D.T. Ingling Company

Ingling Contractor


Wildcat

Ft. from N. Line

330 Ft. from S. Line

330 Ft. from E. Line

Ft. from W. Line

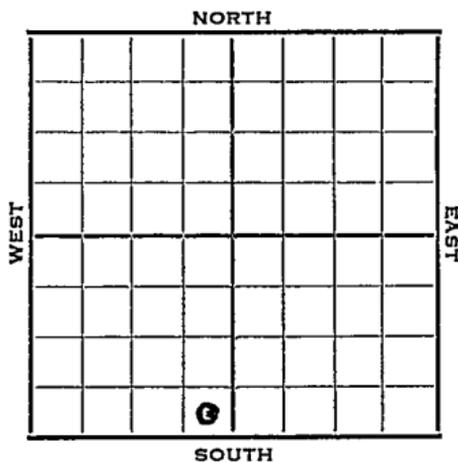

SE SE SW

Amerada, Sunray & Globe-support

1952	REPORT
9/24	MIR
10/1	8" @ 260 Anhy 790' Drlg. 1885'
10/15	Spud 9-25-52 D&A TD 3435' 8" @ 260 Anhy 790 Heeb. 3053 Tor. 3071 Br Li 3143 Lans. 3143 Arb. 3413 TD 3435' D&A
ABANDONED	

