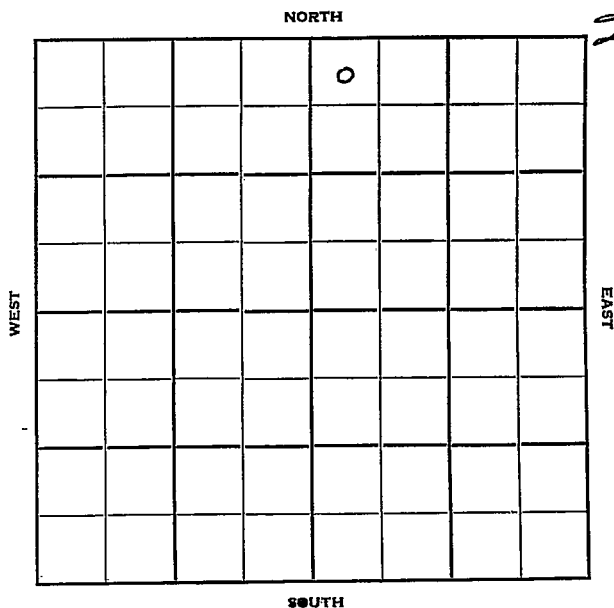


Section 6 Township 17 Range 12-WWell No. #1 SchremmerCompany Duke & Wood

Barton

KANSAS
12W

Sec. 6 Twp. 17 R.

Well No. #1 Schremmer Farm

Duke & Wood Company

Contractor

Reif Pool


330' Ft. from N. Line

Ft. from S. Line

Ft. from E. Line

330' Ft. from W. Line

NW NW NE

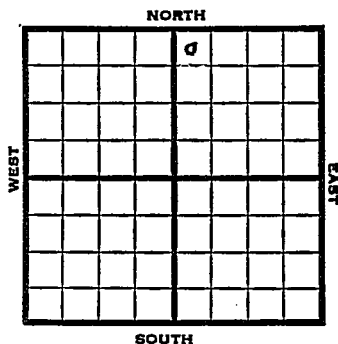

1951

Elev. 1962' REPORT

1/10 Location

2/21 Spud 1-25-51

D & A TD 3440

8" @156

Anhy 850 Heeb. 3076 Br. lime 3164

Lans. 3179 Arb. 3432

TD 3440

5" @3230

Perf. 3214-16 15/ 3204-09

500 A S/ sw SP 3198

24/ 3180-85 1000 A 2 bwph

24/ 3023-26 1000 A 1 bwph

D & A

ABANDONED

County **Barton** State **Kansas**

Sec. **6** (Blk.) **17** (Sur.) **12W** Map No.

Operator **Duke & Wood**

Well No. 1 Farm Schreiner

Elev.	1962	Location	NW NW NE
-------	------	----------	----------

330 Ft. From N Line NE

330 Ft. From **IV** Line Quarter

1st. Report JAN 10 1951

Completion


Remarks

Spudding Date _____

Drig. Data	Ref Pool

Location

J. E. TYRA

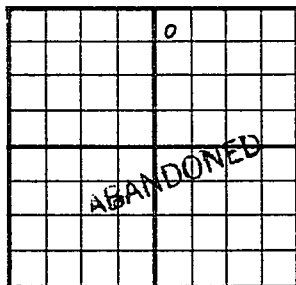County Barton State KansasSec. 6 (Blk. Twp.) 17 (Sur. Rge.) 12W Map No.Operator Duke & WoodWell No. 1 Farm SchremmerElev. 1962 Location NW NW NE330 Ft. From N Line NE330 Ft. From W Line Quarter

1st. Report

Completion FEB 21 1951Remarks Reif PoolSpudding Date 1-25-51Drlg. Data D & A TD 34408" @ 156 Anhy 850 Heeb. 3076Br. lime 3164 Lans. 3179 Arb. 3432TD 3440 5" @ 3230 Perf. 3214-1615/ 3204-09 500 A S/ sw SP 319824/ 3180-85 1000 A 2 bwph 24/ 3023-26 1000 A 1 bwphD & A

J. E. TYRA