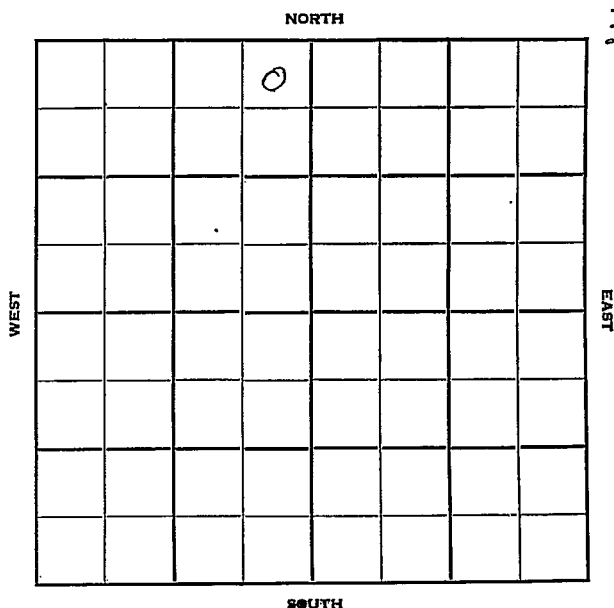


Barton

KANSAS

Section 6 Township 17 Range 12WWell No. #1 WilliamsCompany J. P. Gatty

Barton

KANSAS

6

17

12W

Sec. _____ Twp. _____ R. _____

Well No. #1 Williams Farm

J. P. Gatty Company

Sterling Drlg. - Contr. Contractor


330' Ft. from N. Line

_____ Ft. from S. Line

330' Ft. from E. Line

_____ Ft. from W. Line

NE NE NW

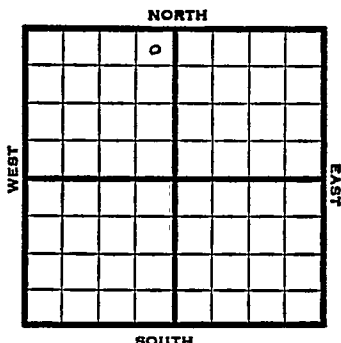

1950

Elev. 1967

REPORT

12/13

Spud 12-12-50

1951

1/31

Oil well TD 3441

8" @185

Anhy 860 Heeb. 3082 Br. lime 3171

Lans. 3189

DST 3191-3223 open 1 hr. Rec. 62' ho
& gcm. Sat. 3233-38 3340-43

Arb. 3432-41

5" @3434

24/3341-45 1000 A 1 boph SP 3228


16/3213-21 32/ 3210-14 2000 A

S/ 3 boph SP 3200 32/ 3190-94

2000 A S/ 5 boph

Comp. 90 bopd

COMPLETED

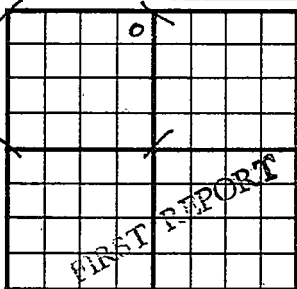County Barton State KansasSec. 6 (Blk.) 17 (Sur.) 12W Map No.Operator J. P. GattyWell No. 1 Farm WilliamsElev. Location NE NE NW330 Ft. From N Line NW330 Ft. From E Line Quarter1st. Report DEC 13 1950


Completion

Remarks

Sterling Drlg. - Contr.Spudding Date 12-12-50

Drlg. Data

J. E. TYRA

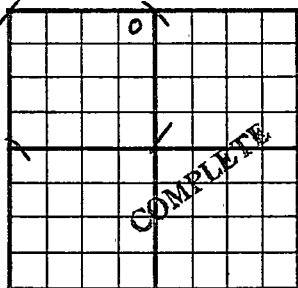County Barton State KansasSec. 6 (Blk.) 17 (Sur.) 12W Map No.Operator J. P. GattyWell No. 1 Farm WilliamsElev. 1967 Location NE NE NW330 Ft. From N Line NW330 Ft. From E Line Quarter

1st. Report

Completion JAN 31 1951

Remarks

Sterling Drlg. - Contr.Spudding Date 12-12-50Drlg. Data Oil well TD 34418" @ 185 Anhy 860 Heeb. 3082Br. lime 3171 Lans. 3189 DST 3191-3223open 1 hr. Rec. 62' ho & gem Sat. 3233-38 3340-43 Arb. 3432-41 5" @ 343424/ 3341-45 1000 A 1 boph SP 322816/ 3218-21 32/ 3210-14 2000 AS/ 3 boph SP 3200 32/ 3190-942000 A S/ 5 boph Comp. 90 bopd

J. E. TYRA