


Section 3 Township 13 Range 17W

Well No. 1 Schmeidler

Company Fleming & Woodman

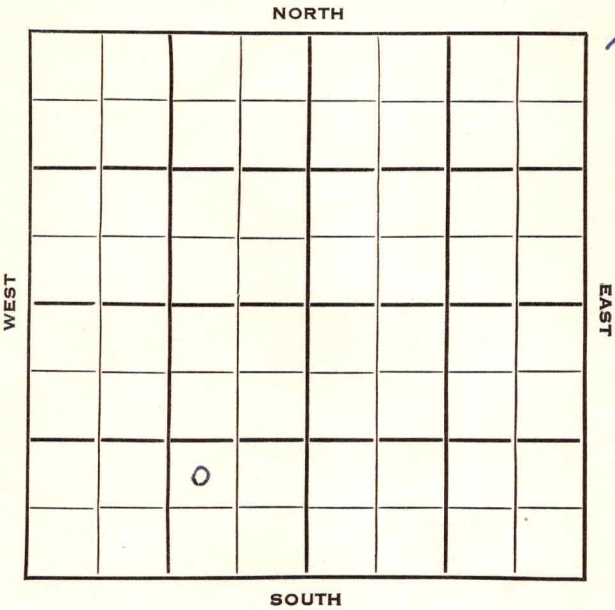

Ellis

KANSAS

SEC.	TWP.	R.
3	13	17W ✓

WELL NO.

#1 Schmeidler

FARM

COMPANY

Fleming & Woodman

CONTRACTOR

Fleming & Woodman

Catherine Pool

NORTH

_____ Ft. from N. Line


990

_____ Ft. from S. Line

990

_____ Ft. from E. Line

_____ Ft. from W. Line

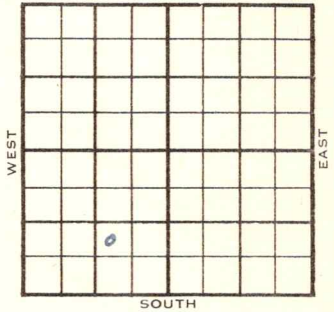

NW SE SW

	ELEVATION	REPORT
1954	2032'	

4/14

R U R

4/28

Spud 4-12-54

D&A

TD 3606'

8" @ 163'

Anhy 1215', Heeb 3256', Lans 3303'

DST 3326-37', opn 1 hr., rec. 95' mud, 330#

Cong 3540'

TD 3606'

D&A

ABANDONED

County Ellis State KansasSec. 3 (Blk. 13 (Sur. 17W (Twp. 13 (Rge. 17W Map No. 13Operator Fleming & WoodmanWell No. 1 Farm SchmeidlerElev. 2032 Location NW SE SW990 Ft. From S Line SW990 Ft. From E Line Quarter1st. Report APR 28 1954Completion APR 28 1954Remarks Catherine PoolFleming & Woodman - ContrSpudding Date 4-12-54Drilg. Data D & A TD 36068" @ 163 Anhy 1215 Heeb. 3256Lans. 3303 DST 3326-37 open 1 hr.Rec. 95' mud 330# Cong. 3540 TD 3606D & A

J. G. McGEHEE

County **Ellis** State **Kansas**

Sec. **3** (Blk.) **13** (Sur.) **17W** Map No.

Operator **Fleming & Woodman**

Well No. **1** Farm **Schmeidler**

Elev.	Location	NW SE SW
-------	----------	----------

990 Ft. From S Line SW

990 Ft. From **E** Line Quarter

1st. Report APR 14 1954

Completion

Remarks

Fleming & Woodman - Contr.

Spudding Date _____

Drig. Data Catherine Pool

R U R

J. G. McGEHEE