


Section 8 Township 17 Range 12W

Well No. #1 Schremmer

Company Sohio

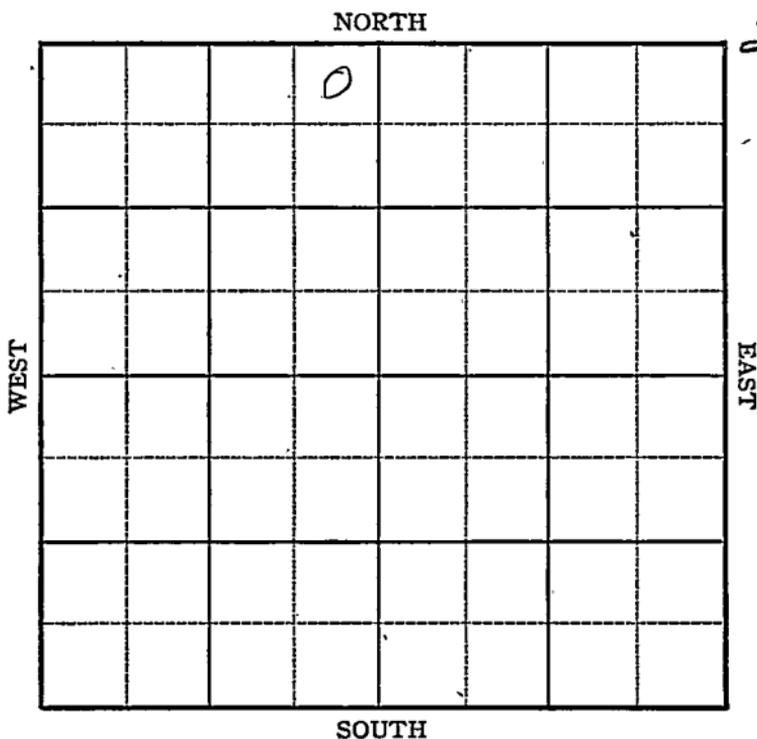

Sec. 8 Twp. 17 R. 12W

Well No. #1 Schremmer Farm

Sohio Company

Ainsworth


330 Ft. from N. Line

_____ Ft. from S. Line

330 Ft. from E. Line

_____ Ft. from W. Line

elev. 1918

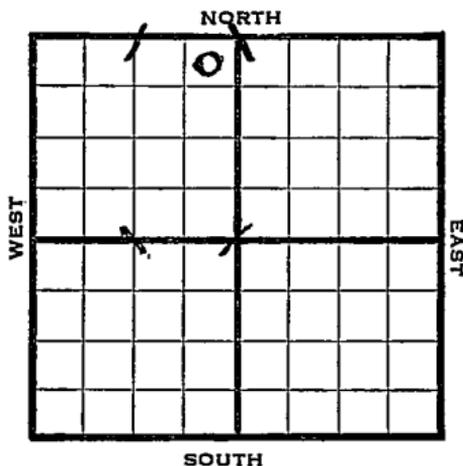

1944

REPORT

- 4/26 Location
- 5/3 "
- 5/10 Drlg. 1694
8" @ 521
- 5/17 Drlg. 2888
- 5/24 - Topeka 2752
Lans 3152
Arb 3415
vTD 3465

ABANDONED

KANSAS

Pool Name Ainsworth

Map No. 55 Sec. 8 Twp. 17 R. 12W

Well No. 1 Schrenmer

Sohio Company

FIRST REPORT Contractor

NE NW


SECTION PLAT

330 Ft. from N. Line

_____ Ft. from S. Line

330 Ft. from E. Line

_____ Ft. from W. Line

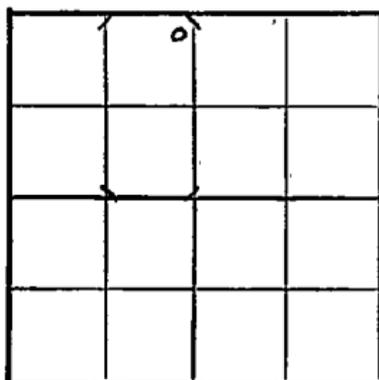

Barton County

Location X

Rig up _____

Drilling and Remarks:

RECORD

Cased _____ in., _____ ft.

Sand _____

Gas _____

Oil _____

Total Depth _____

PRODUCTION

1st 24 hrs. Nat. _____

1st 24 hrs. after shot _____

Gas _____ Cu. Ft.

Dry Hole _____

Abandoned _____

Date

APR 26 1944 19

S. J. LEWIS

Scout

KANSAS

Pool Name Ainsworth

Map No. 55 Sec. 8 Twp. 17 R. 12 W

Well No. 1 Schremmer

Sohio Company

ABANDONED

Contractor

NE NW

SECTION PLAT

330 Ft. from N. Line

_____ Ft. from S. Line

330 Ft. from E. Line

_____ Ft. from W. Line

Barton County

Location _____

Rig up _____

Drilling and Remarks:

Topeka 2752

Lans 3152

Ac 43415

RECORD

Cased _____ in., _____ ft.

Sand _____

Gas _____

Oil _____

Total Depth 3465

PRODUCTION

1st 24 hrs. Nat. _____

1st 24 hrs. after shot _____

Gas _____ Cu. Ft.

Dry Hole _____

Abandoned _____

Date

MAY 24 1944 19 _____

S. J. LEWIS Scout