


Section 8 Township 17 Range 12W

Well No. #1-A Schremmer

Company Pickrall & Franco Central

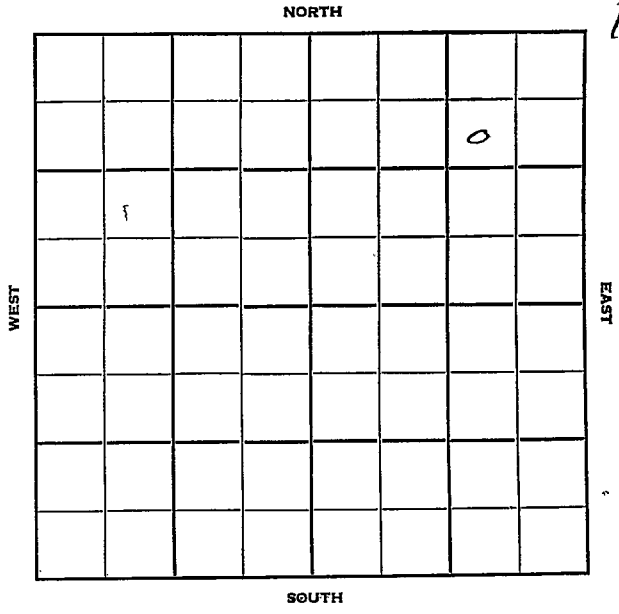

Sec. 8 Twp. 17 R. 12W

Well No. #1-A Schremmer Farm

Pickerall & Franco Central Company

Pickerall Contractor


990 Ft. from N. Line

Ft. from S. Line

990 Ft. from E. Line

Ft. from W. Line

SW NE NE

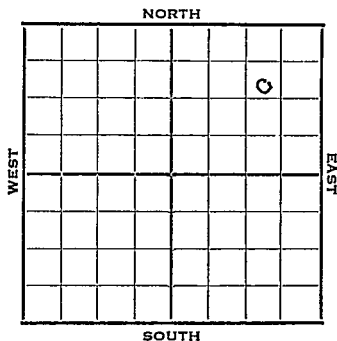

1952 Elev. 1903 REPORT

3/5 Spud 3-1-52  
8" @ 200'  
Drlg. 1565'

3/12 Spud 3-1-52  
B&A TD 3425  
8" @ 200 Heeb. 3016  
Lans. 3110 Arb. 3373  
TD 3425 D&A

**ABANDONED**



