

Form 51-5M-3-35-Mid-West

Map No. KANSAS Sec. 3 Twp. 13 R. 17W


Well No. #1-Schmeidler Farm

Harris & Haun et al Company

NORTH

WEST

EAST

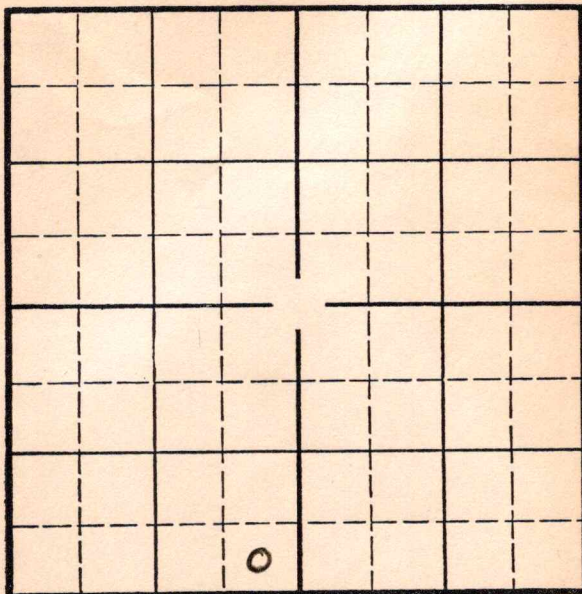

SOUTH

O. W. D. D

Location

Drilling Remarks

Rig Up

Drilling Remarks

RECORD

Cased in. ft.

Sand

Gas

Oil

Total Depth

PRODUCTION

1st 24 hrs. Nat.

1st 24 hrs. after shot

Gas cu. ft.

Dry Hole

Abandoned

719260

Top Oswald 3294

6/11--Water 3328-33 Water exhausting
From 3338-41 show oil

At ~~XXXX~~ 3354 show gas

From 3359-61 oil

Filled up 400 feet in 2 hours

1200 feet oil in 6 hrs.

Let set 24 hrs.

Build tanks and test

Estimate 35 to 38 grav. (Tel)

6/15--Underreamed 7" to 3303

Total Depth 3361

Cement pipe

Will test tomorrow

Have 2600 feet oil in hole

34 Gravity (Tel)

6/22--Acidized 5000 gallons acid

Pumped 676 bbls. (Telegram)

6/24/36-Lansing 3274'.

Oil 3308-58'.

5000 gallons of acid.

T.D. 3362'.

Pump 676 bbls oil.

28.3 gravity oil and no water.

COMPLETED

1940

O. W. D. D

5/29

Old T.D. 3362'

Congl. 3522'

Arb. 3525'

Increase oil.

6/6

Shut down.

6/13

" "

6/20

" "

OVER

1940
6/26

Arb. 3525'

No shows.

T.D. 3541'

P.B. to 3482'

1000 acid.

Potential 185 bbls., pump.

COMPLETED

Ettes
Map No. 71 Sec. 3 Twp. 13 R. 17W

Well No. 1 Schmiedler

Harris & Haun et al. Company

Contractor

SECTION PLAT

 Ft. from N. Line

330 Ft. from S. Line

330 Ft. from E. Line

 Ft. from W. Line

COMPLETED

Location

Rig up

Drilling and Remarks:

Lansing 3274

Oil 3308-58

5000 acid

Pump 676 ft.

28 3/4 gal oil No Water

RECORD

Cased in., ft.

Sand

Gas

Oil

Total Depth 3362

PRODUCTION

1st 24 hrs. Nat.

1st 24 hrs. after shot

Gas Cu. Ft.

Dry Hole

Abandoned

Date

JUN 24 1936 19

S. J. LEWIS

Scout

KANSAS

Map No. 71 Sec. 3 Twp. 13 R. 17WWell No. 1 - Schmiedler
Harris & Haun Company

Contractor

FIRST REPORTS

SECTION PLAT

Ft. from N. Line

330 Ft. from S. Line330 Ft. from E. Line

Ft. from W. Line

Location

Rig up

Drilling and Remarks:

Cellar & Material

RECORD

Cased in., ft.

Sand

Gas

Oil

Total Depth

PRODUCTION

1st 24 hrs. Nat.

1st 24 hrs. after shot

Gas Cu. Ft.

Dry Hole

Abandoned

Date

ORVAL MANNSCHRECK

4-1-36 192

Scout

Map No. 71 Sec. 3 Twp. 13 R. 17WWell No. 1 SchniedlerHarris & Hahn etal

Company

Contractor


FIRST REPORT

SECTION PLAT

SE SW

 Ft. from N. Line330 Ft. from S. Line330 Ft. from E. Line Ft. from W. Line

CATHERINE POOL

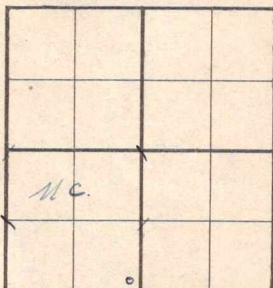Location Rig up

Drilling and Remarks:

OWDD-OTD 3362

Congl. 3522

Arb. 3525

Incr. Oil

RECORD

Cased in., ft.Sand Gas Oil Total Depth

PRODUCTION

1st 24 hrs. Nat. 1st 24 hrs. after shot Gas Cu. Ft.Dry Hole Abandoned

Date

MAY 29 1940

19

S. J. LEWIS

Scout

Map No. 71 Sec. 3 Twp. 13 R. 17WWell No. 1 SchmiedlerHarris & Haun etal

Company

Contractor

COMPLETED

SE SW

 Ft. from N. Line330 Ft. from S. Line330 Ft. from E. Line Ft. from W. Line

CATHERINE POOL

SECTION PLAT

Location Rig up

Drilling and Remarks:

*Art 3525**Noe howe**PB 3482.**1000 acid**Pump 185 ft.*

RECORD

Cased in., ft.Sand Gas Oil Total Depth 3541

PRODUCTION

1st 24 hrs. Nat. 1st 24 hrs. after shot Gas Cu. Ft.Dry Hole Abandoned

Date

JUN 26 1940 19S. J. LEWIS

Scout

*Kansas Not
Notified about
Purchase agreements
R.D.*

COUNTY Ellis

STATE Kansas

Lease Purchase Agreement

Location of well SE of SE of SW Sec. 3 Twp. 13S Range 17 W

To whom D. J. Marshall, 403 Union Natl Bank Bldg, Wichita, Kans.

Commence by Apr 15, 1936

Completed by _____

Depth Test Siliceous lime

Our lease expires new 5 years

Contract dated 3-23-36

Our lease affected We are buying the N $\frac{1}{2}$ SW $\frac{1}{4}$ Sec 3, and W $\frac{1}{2}$ SW $\frac{1}{4}$ Sec 10,
13S-17W, subject to the completion of the above well

Remarks: We are to have access to the well at all times and be entitled to all information in connection with the well and to be furnished such samples etc as we may request. Other usual terms of lease purchase agreement.

X

REPORTS ON WELL